

County: Tallahatchie  
 Permit #: CW44044  
 Irrigation Equipment  
 Driller: \_\_\_\_\_  
 Date drilling completed: 1-15-10

**State Well Report**  
**Part 1 - Driller's Log**  
 Mississippi Department of Environmental Quality  
 Office of Land and Water Resources  
 P.O. Box 2309  
 Jackson, MS 39225  
 (601)961- 5210  
 (601)961- 5228 (fax)

For Office Use Only:  
 Aquifer: Kill  
 Well #: \_\_\_\_\_  
 L. S. Elevation: \_\_\_\_\_  
 E-log #: \_\_\_\_\_

*State Law requires that this report be prepared by the license holder responsible for the work and filed with the Department at the above address within 30 days of completion of drilling of the well or borehole.*

Information on Well Owner (Landowner if borehole is not for a water well)	Well or Borehole Location
Owner Name: <u>Joseph Murphy Jr. Farms</u>	Latitude: <u>33° 54.21'</u> Longitude: <u>90° 09.28'</u>
Mailing Address: <u>P.O. Box 40</u>	Method of Lat/Long (circle one): Conventional Survey,
<u>Tippo</u> <u>Ms.</u>	USGS quad, Hand-held GPS, Survey-grade GPS
City State Zip Code	<u>SE 1/4 NE 1/4</u> Sec <u>35</u> Twn <u>24N</u> Rng <u>1E</u>
Telephone No. ( ) _____	Distance Direction Nearest Town <u>1</u> Miles <u>SE</u> of <u>Tippo</u>

**Well / Borehole Data**

Date drilling started: 1-15-10 Date drilling completed: 1-15-10 Hole depth: 91 Hole diameter: 18"

Location of the source of any surface water used for drilling: Surface water

Method of dosing and volume of Chlorine used in drilling and development: 50 ppm

Logs run (circle all applicable): (No log run) Electric Gamma Ray Density Sonic Neutron Other: \_\_\_\_\_

Name of organization running log(s): \_\_\_\_\_

Purpose of borehole (check one): Water Well  Geotechnical/Geological Investigation \_\_\_\_\_ Ground Source Heat Pump \_\_\_\_\_

Seismic Survey \_\_\_\_\_ Other (describe) \_\_\_\_\_

*If drilling is not related to water well construction, skip the remainder of this block*

Purpose of Well (check one): Home \_\_\_\_\_ Industrial \_\_\_\_\_ Public Supply \_\_\_\_\_ Irrigation  Fish Culture \_\_\_\_\_ Other: \_\_\_\_\_

If a flowing well, method of flow regulation: Valve \_\_\_\_\_ Other (describe) \_\_\_\_\_

Static Water Level: 9' feet above or below (circle one) land surface Date measured: 1-27-2010

Method of Measurement (circle one) (steel tape) electric tape air line other: \_\_\_\_\_

Well depth: 91 Well grouted to a depth of 10 feet Type of grout (circle one): Neat Cement (Bentonite) Mix

Casing length: 51 feet Casing diameter: 10 inches Type of casing: PVC

Screen length: 40 feet Screen diameter: 10 inches Type of screen: PVC

Screen slot size: .050 inches Setting depth: From 52 feet to 91 feet

Type of completion (circle all applicable): (Gravel packed) Underreamed Telescoped Open hole Natural Development

Other (describe): \_\_\_\_\_

Top of lap pipe or reduction in casing: \_\_\_\_\_ feet. *If telescoped or more than one screen, describe on next page*



# STATE WELL REPORT

## Part 2

**Pump Installer's Completion Report**  
 Mississippi Department of Environmental Quality  
 Office of Land and Water Resources  
 P.O. Box 2309  
 Jackson, MS 39225  
 (601)961-5210  
 (601)961-5228 (fax)

County: Tallahatchie  
 Permit #: \_\_\_\_\_  
 Irrigation Equipment  
 Driller: \_\_\_\_\_  
 Date completed: 1-15-10  
*Copy information from block on Part 1*

**For Office Use Only:**

Aquifer: KILL  
 Well #: \_\_\_\_\_  
 Elevation: \_\_\_\_\_

*This part of the report must be completed by a licensed water well contractor or a licensed pump installer. A copy of Part 1 of the report must be attached and both parts filed with the Department at the above address within 30 days of well completion.*

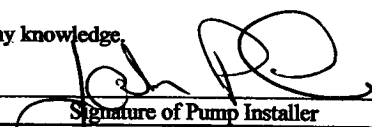
Well Owner Information	Well Location
Owner Name: <u>Joseph Murphy Jr. Farms</u>	Latitude: _____ Longitude: _____
Mailing Address: <u>P.O. Box 40</u>	Method of Lat/Long (check one): Conventional Survey _____ USGS quad _____, Hand-held GPS _____, Survey-grade GPS _____
<u>Tippo</u> <u>Ms.</u>	<u>SE 1/4 NE 1/4 Sec 35 T24N R 1E</u>
City State Zip Code	Distance Direction Nearest Town
Telephone No. ( ) _____	<u>1</u> Miles <u>SE</u> of <u>Tippo</u>

Pump Type Circle one	Power Type Circle one
Air Lift Jet <input checked="" type="radio"/> <u>Submersible</u>	Diesel Engine Gasoline Engine Natural Gas
Bucket Piston Turbine	<input checked="" type="radio"/> <u>Electric Motor</u> Hand Tractor PTO
Centrifugal Rotary Flowing Well	Windmill Other (specify): _____
Other (specify): _____	Horse Power Rating of Motor: <u>15</u>
Date Pump Installed: <u>1-27-2010</u>	Setting Depth: <u>70</u> feet
Rated Pump Capacity: <u>750+</u> Gallons Per Minute	Number of Stages: <u>1</u>

Pump Test Data	Method of Measuring Water Level Circle one
Date Well Tested: _____	Air Line Electric Measuring Line Steel Tape
Static Water Level (A): _____ Feet Below Land Surface	Other (specify): _____
Pumping Water Level (B): _____ Feet Below Land Surface	For flowing well, measured shut in head: _____ feet
Drawdown [(B) - (A)]: _____ Feet Below Land Surface	Well yielded _____ GPM with a drawdown of _____ feet after _____ hours of pumping
Test Pumping Rate: _____ Gallons Per Minute	
Duration of Pump Test (minimum 4 hours): _____ hours	

I HEREBY CERTIFY that the above statements are true to the best of my knowledge.

John P. Chism 0439  
 Print Name of Pump Installer and License No. (if applicable)

  
 Signature of Pump Installer