

TALLAHATCHIE

K 2002

1-24-79

MISSISSIPPI BOARD OF WATER COMMISSIONERS 416 North State Street Jackson, Mississippi 39201

WATER WELL DRILLERS LOG

BUTANE GAS COMPANY OF GREENWOOD

Tallahatchie county well located

1-24-79 date well completed

Table with 4 columns: LANDOWNER, description of formations encountered, from, to. Includes handwritten entries for Tony Young, Charleston, well location (3 1/2 miles W of Tipps), well purpose (Home), and well completion data (4x2 diameter, 797 total depth, 777 casing depth).

RECEIVED

JAN 25 1978

MISS. DD. OF WATER COMM


If well telescopes please sketch and show depths.

GROUND LEVEL

105' - 4" CASING →

67' - 2" CASING →

20' - 2" SCREEN →

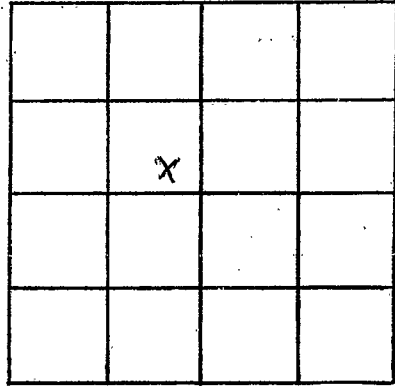

SECTION 30

Please indicate well location X.

ADDITIONAL INFORMATION

If more than one screen,
show locations of each on sketch.