

TALLAHATCHIE

K 2003

04-17-79

MISSISSIPPI BOARD OF WATER COMMISSIONERS 416 North State Street Jackson, Mississippi 39201

WATER WELL DRILLERS LOG

BUTANE GAS COMPANY OF GREENWOOD

Tallahatchie county well located

4-17-79 19 date well completed

LANDOWNER: John Strider Charles Dow (mailing address) WELL LOCATION: sec. 3 T 24 N R 1 E 7 miles NE of Webb (distance) (direction) (nearest town)

Table with 3 columns: description of formations encountered, from, to. Rows include Clay, Sand, Sand & Gravel, Clay, Shale & Clay, Sand & Shale, Fine Sand, Coarse Sand.

WELL PURPOSE: Home (home, irrigation, municipal, industrial)

WELL COMPLETION DATA: (1) diameter (inches) 4 1/2 (2) total depth (feet) 651 (3) static water level (feet) 1 below top of ground. (4) casing Steel 631 (material) (depth) 4 1/2 if telescope see back. (size) (5) screen 20 631 (length) (depth to top) 2" STAINLESS (size) (material) (6) pump 1 18 (HP) (yield gpm) Elec. (type power) (7) electric log NU (yes or no) (organization running log)

Empty table grid for well completion data.

(8) how well bottom plugged Back Pressure Valve

DRILLERS REMARKS:

Miss. Board of Water Comm.

APR 18 1979

RECEIVED


If well telescopes please sketch and show depths.

GROUND LEVEL

105' - 4" CASING - 7

526' - 2" CASING - 1

20' - 2" SCREEN - 7

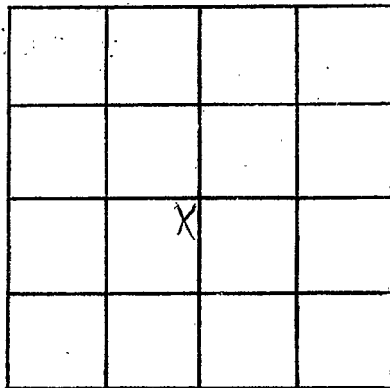

SECTION 3

Please indicate well location X.

ADDITIONAL INFORMATION

If more than one screen, show locations of each on sketch.