

MISSISSIPPI DEPARTMENT OF NATURAL RESOURCES

Bureau of Land and Water Resources

Southport Mall

P.O. Box 10631

Jackson, Mississippi 39209

WATER WELL DRILLERS LOG

BUTANE GAS COMPANY.

Tallahatchie

Tallahatchie
K 2000

9-19 1984
date well completed

OF GREENWOOD

county well located

LANDOWNER: Ronnie Davis
Tippo Mo.
(mailing address)

WELL LOCATION:
sec. 26 T 24 N R 1 E
3/4 miles NE of Tippo
(distance) (direction) (nearest town)

WELL PURPOSE:
(home, irrigation, municipal, industrial)

WELL COMPLETION DATA:

- (1) diameter (inches) 4" x 2"
- (2) total depth (feet) 623
- (3) static water level (feet) 0 ^{below}/_{above} top of ground.
- (4) casing 2" steel 4"-126'
(material) (depth)
2" steel 2"-451'
4"
2" if telescope see back.
(size)
- (5) screen 20' 577
(length) (depth to top)
2" steel
(size) (material)
- (6) pump 1 20
(HP) (yield gpm)
Elect
(type power)
- (7) electric log No
(yes or no)
No
(organization running log)
- (8) how well bottom plugged Back wash Valve

description of formations encountered	from	to
Clay	0	15
SAND	15	55
some gravel	55	70
gravel	70	105
sand	105	140
clay	140	180
shale rock	180	315
quarry shale	315	360
concrete "	360	385
found some	385	465
SAND shale st.	465	570
sand	570	610
shale sand. st.	610	623

DRILLERS REMARKS:
Richard Vest Sr.


DEPT. OF NATURAL RESOURCES
BUREAU OF LAND & WATER RESOURCES

OCT 22 1984

RECEIVED

If well telescopes please sketch and show depths.

GROUND LEVEL

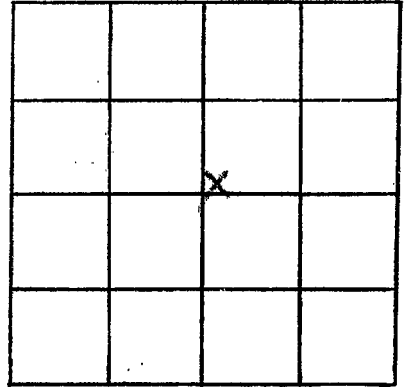

SECTION 26

Please indicate well location X.

ADDITIONAL INFORMATION

If more than one screen,
show locations of each on sketch.