

TALLAHATCHIE
K 2008
12-01-78

**MISSISSIPPI
BOARD OF WATER COMMISSIONERS**
416 North State Street
Jackson, Mississippi 39201

WATER WELL DRILLERS LOG

Dec. 1, 1978 Bruce Berryman - TALLAHATCHIE
 date well completed firm name county well located
 Greenwood, Miss.

LANDOWNER: CON FCRV	description of formations encountered	from	to
Tippo.			
Miss. 38962	Clay	0	20
(mailing address)	Sand	20	60
WELL LOCATION:	Sand & gravel	60	100
sec. 15 T 23 R 1 E	Clay	100	120
3 miles N of TIPPO.	Sand & gravel	120	140
(distance) (direction) (nearest town)	Shale	140	200
WELL PURPOSE: Industrial	Shale & rock	200	250
(home, irrigation, municipal, industrial)	Sand	250	260
WELL COMPLETION DATA:	Sand & rock	260	290
(1) diameter (inches) 6" x 4"	Shale & rock	290	300
(2) total depth (feet) 649'	Sand	300	320
(3) static water level (feet) 0 below top of ground.	Shale	320	380
(4) casing 6" Blk. 168' / 4" Blk. 441'	Sand	380	400
(material) (depth)	Shale	400	440
(size) If telescope see back.	Sandy shale	440	510
(5) screen 40' / 609'	Sand	510	530
(length) (depth to top)	Shale	530	560
.010 4" stainless steel	Sand	560	660
(size) (material)	Clay	660	670
(6) pump 7 1/2 (HP) 250 (yield gpm)			
Electric (type power)			
(7) electric log No (yes or no)			
(organization running log)			
(8) how well bottom plugged B.P.V.			
DRILLERS REMARKS:			


Miss. Board of Water Comm.

MAY 28 1979

RECEIVED

If well telescopes please sketch and show depths.

GROUND LEVEL

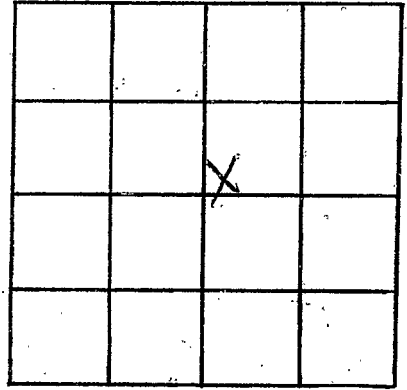

SECTION 15

Please indicate well location X.

ADDITIONAL INFORMATION

If more than one screen,
show locations of each on sketch.