

TALLA.
L 6

WATER WELL DRILLERS LOG

CODED

Jacksonville

Date: 2, 28, 1962 Driller: Jas. R. Liper

County: Putnam

8-28-62

(Name)

(1) Owner of Land: Russell Taylor

(Name)

Raynes Miss.

(Address)

(2) Location: 1/4, 1/4, Sec 24 24 2 TR E

2 miles east of Cypress

(distance)

(direction)

(Nearest Town)

(3) Topography: Hilly

(Hilly)

(Flat)

(Level)

(4) Purpose of Well: Domestic

(Domestic Irrigation
Municipal, Industrial, Other)

Description & Color of Materials
Sand, Clay, Red Clay, Shell, etc.

Thick-
ness
Feet

Depth
Feet

Clay	0	20
Sand	20	80
Gravel	80	130
Sand	100	184
Black Clay	189	231
Water sand	231	248

Information upon completion of well:

(1) Diameter 9 inches.

(2) Total Depth 248 feet.

(3) Water Level 160 feet below top of ground.

(4) Cased to 231, Size 9"

(5) Screen: Size 1/4, Length 6'


(6) Were any formations sealed against pollution?

yes, no.

If YES depth of formation

Why

Drillers Remarks:

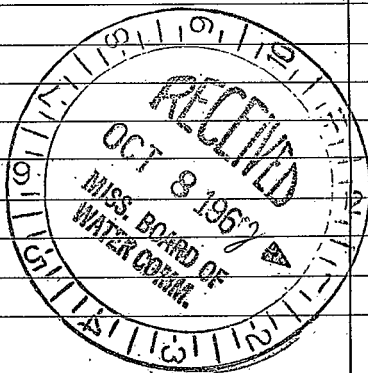

(Use Back Side)

Well No.

