

Jallahatchie

L 9
5-6-64

James O. Lepe
WATER WELL DRILLERS LOG

Jallahatchie

Date: May 6, 1964, Driller: Frank J. Jolly County Pondre
(Name) James O. Lepe

(1) Owner of Land: Blenched Carothers
(Name)
Jallahatchie, Miss
(Address)

(2) Location: 1/4, 1/4, Sec. 11 T. 24 N. R. 2 E.
3 miles So. of Charleston
(distance) (direction) (Nearest Town)

(3) Topography: Hilly
(Hilly) (Flat) (Level)

(4) Purpose of Well: Domestic
(Domestic Irrigation
Municipal, Industrial, Other)


Description & Color of Materials Sand, Clay, Red Clay, Shell, etc.	Thick- ness Feet	Depth Feet
<u>gravel</u>	<u>0</u>	<u>45</u>
<u>Clay Sand</u>	<u>45</u>	<u>125</u>
<u>W. Sand</u>	<u>125</u>	<u>176</u>

Information upon completion of well:

- (1) Diameter 2 inches.
- (2) Total Depth 176 feet.
- (3) Water Level 85 feet below top of ground.
- (4) Cased to 168, Size 2.
- (5) Screen: Size 1/4, Length 6.
- (6) Were any formations sealed against pollution?
_____ yes, _____ no.

If YES depth of formation _____
Why _____

Drillers Remarks: _____

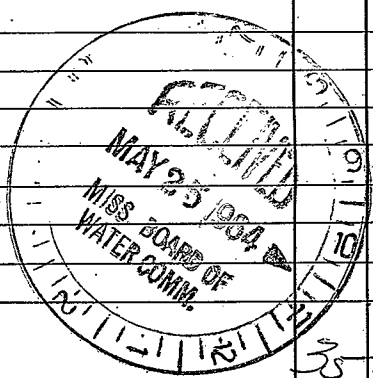

(Use Back Side)

Well No. 38

