

Tallahatchie
 L 11
 3-7-73

MISSISSIPPI **CODED**
 BOARD OF WATER COMMISSIONERS
 416 North State Street
 Jackson, Mississippi 39201

WATER WELL DRILLERS LOG

CODED

3-7 1973 James B. Lipe Tallahatchie
 date well completed firm name county well located

LANDOWNER:
 William C. Thomas
 Charleston Miss.
 (mailing address)

WELL LOCATION:
 sec. 25 T 24 N R 2 E
 S W
 10 miles South of Charleston
 (distance) (direction) (nearest town)

WELL PURPOSE: HOME
 (home, irrigation, municipal, industrial)

- WELL COMPLETION DATA:
- (1) diameter (inches) 4
 - X (2) total depth (feet) 173
 - (3) static water level (feet) 110 below top of ground.
 - (4) casing PVC 163 (material) (depth)
 4 (size) if telescope see back.
 - (5) screen 10 163 (length) (depth to top)
 4 PVC (size) (material)
 - (6) pump 3/4 10 (HP) (yield gpm)
 Elec. (type power)
 - (7) electric log No (yes or no)
 No (organization running log)
 - (8) how well bottom plugged PVC
 plug

description of formations encountered	from	to
Top soil	0	20
Clay	20	40
"	40	60
"	60	80
Gravel	80	100
"	100	120
Gravel and sand	120	140
" " "	140	160
sand	160	173


CODED

APR 5 1973

DRILLERS REMARKS:

If well telescopes please sketch and show depths.

GROUND LEVEL

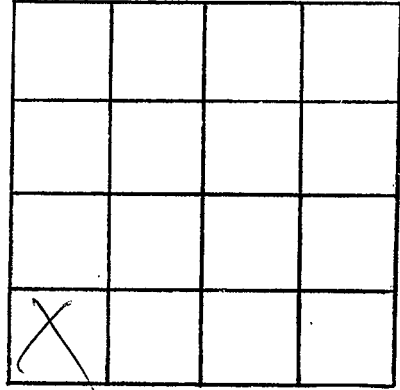

SECTION 25

Please indicate well location X.

ADDITIONAL INFORMATION

If more than one screen,
show locations of each on sketch.