

Tallahatchie

L 12

3-5-73

3-5

date well completed

1973

James R. Lipe

firm name

Tallahatchie

county well located

MISSISSIPPI BOARD OF WATER COMMISSIONERS
416 North State Street
Jackson, Mississippi 39201

CODED

WATER WELL DRILLERS LOG


LANDOWNER:	description of formations encountered	from	to
James Ford	Top soil	0	20
Charleston MISS.	Sand	20	40
(mailing address)	"	40	60
WELL LOCATION:	Clay	60	80
sec. 11 T 24 N R 2 E	"	80	100
3 miles South of Charleston	"	100	120
(distance) (direction) (nearest town)	"	120	140
WELL PURPOSE: HOME	Sand	140	150
(home, irrigation, municipal, industrial)			
WELL COMPLETION DATA:			
(1) diameter (inches) 4"			
X (2) total depth (feet) 150			
(3) static water level (feet) 80 below top of ground.			
(4) casing PVC 140 (material) (depth)			
4 (size) if telescope see back.			
(5) screen 10 140 (length) (depth to top)			
4 (size) PVC (material)			
(6) pump 3/4 10 (HP) (yield gpm)			
Elec. (type power)			
(7) electric log NO (yes or no)			
NO (organization running log)			
(8) how well bottom plugged PVC PIUG			
DRILLERS REMARKS:			

CODED

APR 2 1973

If well telescopes please sketch and show depths.

GROUND LEVEL

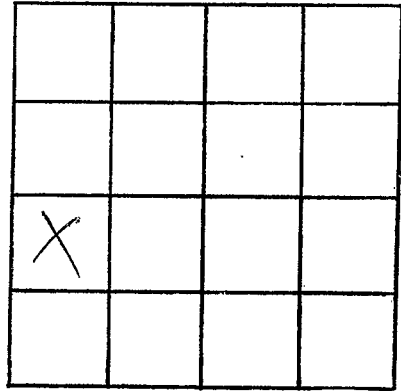

SECTION 11

Please indicate well location X.

ADDITIONAL INFORMATION

A series of horizontal lines for writing additional information, starting below the 'ADDITIONAL INFORMATION' header and extending to the bottom of the page.

If more than one screen, show locations of each on sketch.