

TALLAHATCHIE  
 L 14  
 4-26-74

MISSISSIPPI  
 BOARD OF WATER COMMISSIONERS  
 416 North State Street  
 Jackson, Mississippi 39201

CODED

WATER WELL DRILLERS LOG

4-26 1974 Life Well Co. Tallahatchie  
 date well completed firm name county well located

LANDOWNER:	description of formations encountered	from	to
Edith Hall	TOP soil	0	20
Payne Miss.	Clay	20	40
(mailing address)	SAND	40	60
	Gravel	60	80
	"	80	100
	Sand and gravel	100	120
	Clay	120	140
	"	140	160
	Sand	160	180
	"	180	194

LANDOWNER:

WELL LOCATION:

sec. 25 T 24 N R 2 E  
 S W  
2 miles EAST of Payne  
 (distance) (direction) (nearest town)

WELL PURPOSE:  
 (home, irrigation, municipal, industrial)

WELL COMPLETION DATA:

- (1) diameter (inches) 4
- (2) total depth (feet) 194
- (3) static water level (feet) 80 below top of ground.
- (4) casing PVC 184  
 (material) (depth)  
4 if telescope see back.  
 (size)
- (5) screen 10 184  
 (length) (depth to top)  
4 PVC  
 (size) (material)
- (6) pump 3/4 10  
 (HP) (yield gpm)  
elec.  
 (type power)
- (7) electric log no  
 (yes or no)  
no  
 (organization running log)
- (8) how well bottom plugged PVC Plug


CODED

DRILLERS REMARKS:

REC'D  
 MAY 1  
 MISS. Bd. OF W.C.

If well telescopes please sketch and show depths.

GROUND LEVEL

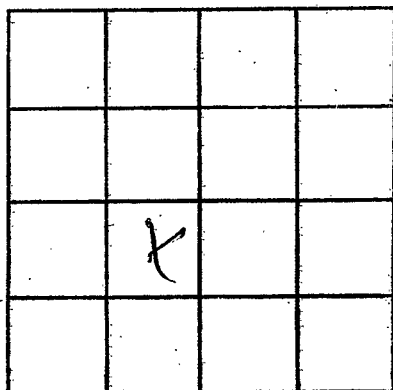

SECTION 25

Please indicate well location X.

ADDITIONAL INFORMATION

If more than one screen,  
show locations of each on sketch.