

Tallahatchie
L-15

MISSISSIPPI
BOARD OF WATER COMMISSIONERS
416 North State Street
Jackson, Mississippi 39201

CODED

WATER WELL DRILLERS LOG

5/5/80
5-5

date well completed

1980 Lipe Well Co.

firm name

Tallahatchie

county well located

LANDOWNER:

Walter Guy Burkhalter
Enid Ms,
(mailing address)

description of formations
encountered

Top soil 0 10
Sand and pea gravel 10 60

WELL LOCATION:

sec 5 T 24 N R 2 E
S W
3 miles S. W. of Charleston
(distance) (direction) (nearest town)

CODED

WELL PURPOSE:

(home, irrigation, municipal, industrial)

WELL COMPLETION DATA:

- (1) diameter (inches) 2
- (2) total depth (feet) 60
- (3) static water level (feet) 8 below above top of ground.
- (4) casing PVC 50 (material), (depth), 2 (size) if telescope see back.
- (5) screen 10 50 (length), (depth to top), 2 PVC (size), (material)
- (6) pump 3 60 (HP), (yield gpm), Gasoline (type power)
- (7) electric log No (yes or no), N/A (organization running log)

- (8) how well bottom plugged PVC CAP

DRILLERS REMARKS:


DEPT. OF NATURAL RESOURCES
BUREAU OF LAND & WATER RESOURCES

MAY 19 1980

RECEIVED

If well telescopes please sketch and show depths.

GROUND LEVEL

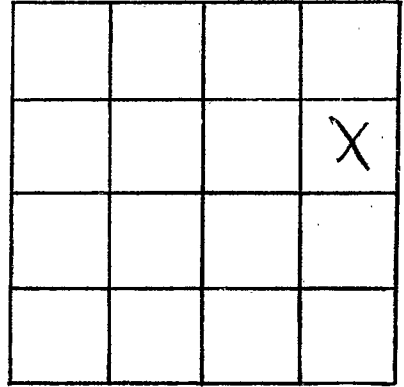

SECTION 5

Please indicate well location X.

ADDITIONAL INFORMATION

If more than one screen, show locations of each on sketch.