

MISSISSIPPI DEPARTMENT OF NATURAL RESOURCES

Bureau of Land and Water Resources

Southport Mall

P.O. Box 10631

Jackson, Mississippi 39209

WATER WELL DRILLERS LOG

CODED

TALLAHATCHIE
L 18

March 9, 1984 Dyer Well & Irrigation Tallahatchie
date well completed firm name county well located

LANDOWNER: <u>William Falls</u>	description of formations encountered	from	to
<u>Webb, Miss</u> (mailing address)	<u>Clay</u>	<u>2</u>	<u>28</u>
	<u>Fine Sand</u>	<u>28</u>	<u>55</u>
	<u>Sand & Gravel</u>	<u>55</u>	<u>102</u>

WELL LOCATION:
 sec. 30 T 24 N R. 1 E
S W
2 miles South of Webb
 (distance) (direction) (nearest town)

CODED

WELL PURPOSE: Irrigation
 (home, irrigation, municipal, industrial)

- WELL COMPLETION DATA:
- (1) diameter (inches) 16"
 - (2) total depth (feet) 102
 - (3) static water level (feet) 24' below above top of ground.
 - (4) casing Steel, 62'
 (material) (depth)
16" if telescope see back.
 (size)
 - (5) screen 40', 62'
 (length) (depth to top)
16", Mild Steel
 (size) (material)
 - (6) pump 40 1,900
 (HP) (yield gpm)
Diesel
 (type power)
 - (7) electric log No
 (yes or no)
 (organization running log)
 - (8) how well bottom plugged Plate

MISSISSIPPI DEPARTMENT OF NATURAL RESOURCES
 BUREAU OF LAND & WATER RESOURCES


JUL - 2 1984

RECEIVED

DRILLERS REMARKS:

If well telescopes please sketch and show depths.

GROUND LEVEL

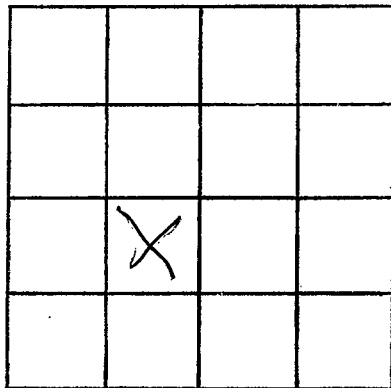

SECTION 30

Please indicate well location X.

ADDITIONAL INFORMATION

If more than one screen,
show locations of each on sketch.