

L19
Tallahatchie
6-25-84

MISSISSIPPI
BOARD OF WATER COMMISSIONERS
416 North State Street
Jackson, Mississippi 39201

CODED

WATER WELL DRILLERS LOG

June 25 1984 Lipa Well Supply Tallahatchie
date well completed firm name county well located

LANDOWNER: Paynes Sew
Paynes MS

description of formations encountered	from	to
clay	0	20
Sand streaked clay	20	60
Sand	60	85

(mailing address)

WELL LOCATION:
sec. 27 T. 24N S R. 2 E W
1/4 miles S of Dag MS
(distance) (direction) (nearest town)

WELL PURPOSE:
(home, irrigation, municipal, Industrial)

CODED

- WELL COMPLETION DATA:
- (1) diameter (inches) 6
 - (2) total depth (feet) 84
 - (3) static water level (feet) 30 below above top of ground.
 - (4) casing PVC, 64,
(material) (depth)
6 If telescope see back.
(size)
 - (5) screen 20, 64
(length) (depth to top)
6, PVC
(size) (material)
 - (6) pump 5 175
(HP) (yield gpm)
elec
(type power)
 - (7) electric log no
(yes or no)
- (organization running log)
- (8) how well bottom plugged PVC
Crp


DRILLERS REMARKS:

DEPT. OF NATURAL RESOURCES
BUREAU OF LAND & WATER RESOURCES

JUL 10 1984
RECEIVED

If well telescopes please sketch and show depths.

GROUND LEVEL

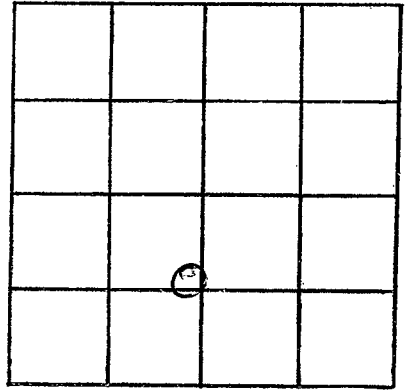

SECTION 27

Please indicate well location X.

ADDITIONAL INFORMATION

If more than one screen, show locations of each on sketch.