

CODED

MISSISSIPPI DEPARTMENT OF NATURAL RESOURCES

Bureau of Land and Water Resources

P.O. Box 10631

Jackson, Mississippi 39209

WATER WELL DRILLERS LOG

COUNTY WELL LOCATED
TALAHATCHIE

WELL NUMBER **3 L 20** CODED

DATE WELL COMPLETED
4-13-88

PERMIT NUMBER
GW 11306

NAME OF DRILLING FIRM
J & K IRRIGATOR

NAME & MAILING ADDRESS OF LANDOWNER
Bud Trout

P.O. Box 441

Charleston, Miss

WELL LOCATION: SEC **4** TOWNSHIP **24** RANGE **2 N 2 W**

DISTANCE **2 1/2** Miles DIRECTION **SW** of NEAREST TOWN **Charleston**

OTHER LANDMARK

WELL PURPOSE: Home Irrigation, Municipal, Industrial, Fish Pond, etc.

PUMP DATA

PUMP TYPE (Circle One):
 Submersible, Turbine, Jet, Flowing Well,
 Other (Describe)

POWER TYPE (Circle One):
 Electric, Tractor, Diesel, Gasoline, Butane,
 Other (Describe)

Pump Capacity (GPM)	No. of Stages	Setting Depth
2500	2	60 FT.

PUMP TEST

Well yielded **1500** GPM with
 a drawdown of **18** ft.
 after _____ hours of pumping

WELL DATA

Well Depth	Casing Diameter (In.)	Casing Length (Ft.)
117	16	77
Type of Casing	Hole Depth	Depth to Static Water Level
Steel	117	19

TYPE OF COMPLETION: (Circle One or More):
Gravel Packed, Underreamed, Telescoped,
 Natural Development, Open Hole, Other

Top of Lap Pipe or Reduction in Casing

FEET IF TELESCOPED OR MORE THAN ONE SCREEN: USE BACK PAGE

LOG DATA

TYPE OF LOG RUN (Circle One): No Log Run, Electric, Gamma Ray, Density, Sonic, Neutron, Other (Describe)

Name of Organization Running Log

SCREEN DATA

Diameter - Inches	Length - Feet	Slot Size - Inches
16	40	.030
Screen Type	Depth to Bottom - Feet	
Steel	117	

GEOLOGIC DATA (Office Use Only)

Surface Elev.	Geologic Unit	Unit Thickness	Depth to Top
Subs. SWL	Date	Analysis	Aquifer Test

Driller's Remarks

DESCRIPTION OF FORMATIONS ENCOUNTERED	FROM	TO	FORMATIONS (Continued)	FROM	TO
CLAY	0	16			
FINE SAND	16	38			
COURSE SAND & GRAVEL	38	117			


RECEIVED
 11/15/88
 SEP 14 1988

Department of Natural Resources
 Bureau of Land & Water Resources

IF MORE SPACE IS NEEDED, USE BACK

If well telescopes please
sketch and show depths.

GROUND LEVEL

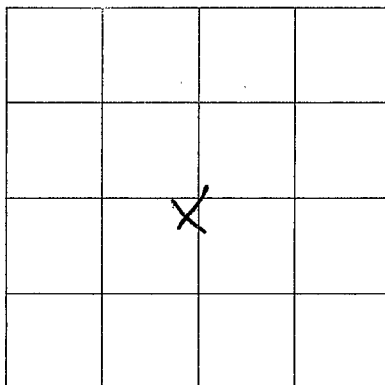

SECTION 4

Please indicate well location X.

ADDITIONAL INFORMATION

If more than one screen,
show location of each on sketch.