

# MISSISSIPPI DEPARTMENT OF NATURAL RESOURCES

Bureau of Land and Water Resources

COUNTY WELL LOCATOR  
**Tala Hatch**  
 WELL NUMBER **211**  
 DATE WELL COMPLETED **7/88**

PERMIT NUMBER  
 NAME OF DRILLING FIRM  
**Powell Inc, Inc**  
**152 BT 303**  
**CLARKES JACO, MS 39612**

**CODED**

P.O. Box 10631  
 Jackson, Mississippi 39209  
**WATER WELL DRILLERS LOG**

NAME & MAILING ADDRESS OF LANDOWNER  
**JACK Webb**  
**Box 9**  
**Summer MS 38957**

WELL LOCATION: SEC **29** TOWNSHIP **24 N** RANGE **2 E**  
W

DISTANCE **6** Miles DIRECTION **SW** NEAREST TOWN **Summer**

OTHER LANDMARK

WELL PURPOSE: Home, Irrigation, Municipal, Industrial, Fish Pond, etc.

PUMP DATA

PUMP TYPE (Circle One): Submersible, Turbine, Jet, Flowing Well, Other (Describe)

POWER TYPE (Circle One): Electric, Tractor, Diesel, Gasoline, Butane, Other (Describe)

Pump Capacity (GPM)	No. of Stages	Setting Depth
<b>1400</b>	<b>3</b>	<b>50 FT.</b>

PUMP TEST

Well yielded \_\_\_\_\_ GPM with a drawdown of \_\_\_\_\_ ft. after \_\_\_\_\_ hours of pumping

WELL DATA

Well Depth	Casing Diameter (In.)	Casing Length (Ft.)
<b>100'</b>	<b>12"</b>	<b>60'</b>
Type of Casing	Hole Depth	Depth to Static Water Level
<b>Steel</b>	<b>100'</b>	<b>22'</b>

TYPE OF COMPLETION: (Circle One or More): Gravel Packed, Underreamed, Telescoped, Natural Development, Open Hole, Other (Describe)

Top of Lap Pipe or Reduction in Casing

FEET IF TELESCOPED OR MORE THAN ONE SCREEN: USE BACK PAGE

LOG DATA

TYPE OF LOG RUN (Circle One): No Log Run, Electric, Gamma Ray, Density, Sonic, Neutron, Other (Describe)

Name of Organization Running Log

SCREEN DATA

Diameter - Inches	Length - Feet	Slot Size - Inches
<b>12"</b>	<b>40'</b>	<b>1030</b>
Screen Type	Depth to Bottom - Feet	
<b>Steel</b>	<b>100'</b>	

GEOLOGIC DATA (Office Use Only)

Surface Elev.	Geologic Unit	Unit Thickness	Depth to Top
Subs. SWL	Date	Analysis	Aquifer Test


Driller's Remarks

DESCRIPTION OF FORMATIONS ENCOUNTERED	FROM	TO	FORMATIONS CONTINUED FROM
<b>CLAY</b>	<b>0</b>	<b>20</b>	<div style="font-size: 2em; opacity: 0.5;">RECEIVED</div> <p>SEP 22 1988</p> <p>Department of Natural Resources                      Bureau of Land &amp; Water Resources</p>
<b>FINE SAND</b>	<b>20</b>	<b>40</b>	
<b>COARSE SAND &amp; GRAVEL</b>	<b>40</b>	<b>100</b>	

IF MORE SPACE IS NEEDED, USE BACK

If well telescopes please sketch and show depths.

GROUND LEVEL

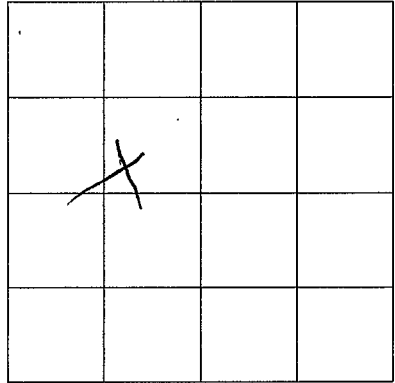

SECTION 29

Please indicate well location X.

ADDITIONAL INFORMATION

If more than one screen,  
show location of each on sketch.