

33-5A-51
96-05-21

MISSISSIPPI DEPARTMENT OF ENVIRONMENTAL QUALITY

Office of Land and Water Resources

P. O. Box 10631
Jackson, MS 39289-0631
WATER WELL DRILLERS LOG

COUNTY WELL LOCATED
Tallahatchie

WELL NUMBER
2-99

CODED

DATE WELL COMPLETED
7-7-03

PERMIT NUMBER

NAME OF DRILLING FIRM
Irrigation Equipment Inc.
Indianola, MS

NAME & MAILING ADDRESS OF LANDOWNER
Eddie Reynolds
900 East Main St.
Charleston, MS 38921

Latitude:
Longitude:

WELL LOCATION. SEC TOWNSHIP RANGE
SW/SE 28 24N S 2E W

DISTANCE DIRECTION NEAREST TOWN
Miles South of Charleston

OTHER LANDMARK
Mid-Valley Pipeline

WELL PURPOSE: Home, Irrigation, Municipal, Industrial, Fish Pond, etc.
Irrigation

WELL DATA

Well Depth	Casing Diameter (In.)	Casing Length (Ft.)
100	16	60

Type of Casing	Hole Depth	Depth to Static Water Level
pvc	100	16ft.

TYPE OF COMPLETION: (Circle One or More):
Gravel Packed, Underreamed, Telescoped,
Natural Development, Open Hole, Other
(Describe)

WELL GROUTED TO A DEPTH OF 10 FEET
Type Grout (circle one): Cement, Bentonite, or Mix

SCREEN DATA

Diameter - Inches	Length - Feet	Slot Size - Inches
16	40	.050

Screen Type	Depth to Bottom - Feet
pvc	100

PUMP DATA

PUMP TYPE (Circle One):
Submersible, Turbine, Jet, Flowing Well,
Other (Describe)

POWER TYPE (Circle One):
Electric, Tractor, Diesel, Gasoline, Butane,
Other (Describe) H/P 40

DESCRIPTION OF FORMATIONS ENCOUNTERED	FROM	TO
Clay	0	38
Fine Sand/gravel	39	50
Med. Sand/gravel	51	100

RECEIVED

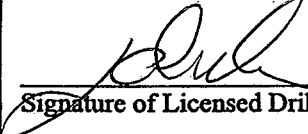
JUL 28 2003

BY: OLWR

Top of Lap Pipe or Reduction in Casing

FEET IF TELESCOPED OR MORE THAN ONE SCREEN: USE BACK PAGE

I certify that the well was drilled, constructed and completed in accordance with all applicable Requirements of the Mississippi Department of Environmental Quality and/or the Mississippi Department of Health regulations and state laws.


Signature of Licensed Driller and License No. 0439

7-23-03
Date

Additional Information Required On Back

If well telescopes please sketch and show depths.

GROUND LEVEL

			X

SECTION 28

Please indicate well location X.

Pump Capacity (GPM)	No. of Stages	Setting Depth
2000	2	70 FT.

PUMP TEST

Well yielded _____ GPM with
a drawdown of _____ ft.
after _____ hours of pumping

LOG DATA

TYPE OF LOG RUN (Circle One): No Log Run, Electric, Gamma Ray, Density, Sonic, Neutron, Other (Describe) _____

Name of Organization Running Log _____

GEOLOGIC DATA (Office Use Only)

Surface Elev.	Geologic Unit	Unit Thickness	Depth to Top
Subs. SWL	Date	Analysis	Aquifer Test

Driller's Remarks

If more than one screen, show location of each on sketch.