

Tallahatchie
 L 2000
 10-16-75

MISSISSIPPI
 BOARD OF WATER COMMISSIONERS
 416 North State Street
 Jackson, Mississippi 39201

WATER WELL DRILLERS LOG

Oct. 16 1975 Lipe Well Co Tallahatchie
 date well completed firm name county well located

LANDOWNER:
 Niel Wrenn
 Charleston Miss.
 (mailing address)

description of formations encountered	from	to
Clay	0	20
sand	20	40
Clay	40	60
"	60	80
"	80	100
sand and clay	100	120
sand	120	140
"	140	153

WELL LOCATION:
 sec. 2 T-24 N R-2 E 15F
 3 miles South of Charleston
 (distance) (direction) (nearest town)

WELL PURPOSE:
 (home, irrigation, municipal, industrial)

WELL COMPLETION DATA:

(1) diameter (inches) 4

(2) total depth (feet) 153

(3) static water level (feet) 30 below top of ground


(4) casing PVO 143
 (material) (depth)
 4 if telescope see back.
 (size)

(5) screen 10 143
 (length) (depth to top)
 4 PVO
 (size) (material)

(6) pump 3/4 10
 (HP) (yield gpm)
 elec.
 (type power)

(7) electric log no
 (yes or no)
 no
 (organization running log)

(8) how well bottom plugged PVO
 plug

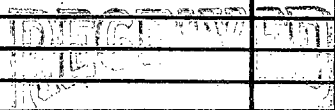


OCT 30 1975

DRILLERS REMARKS:

If well telescopes please sketch and show depths.

GROUND LEVEL

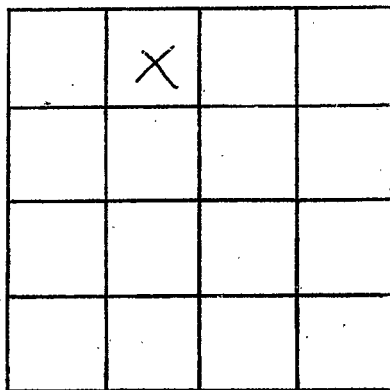

SECTION 2

Please indicate well location X.

ADDITIONAL INFORMATION

If more than one screen,
show locations of each on sketch.