

Tallahatchie
L 2002

MISSISSIPPI
BOARD OF WATER COMMISSIONERS
416 North State Street
Jackson, Mississippi 39201

9-12-79

WATER WELL DRILLERS LOG

9-12
date well completed

1979 Lipe well co.
firm name

Tallahatchie
county well located

LANDOWNER:		description of fomations encountered	from	to
Sonny Taylor Charleston Ms. (mailing address)				
		Sand and gravel	20	180
		Clay	180	220
		Sand and clay	220	260
		" " "	260	320
		sand	320	380
		Clay and sand	380	400
		sand	400	460
		Clay	460	480
		sand	480	535
WELL LOCATION:				
sec. <u>7</u> T <u>24</u> N R. <u>2</u> E				
<u>4</u> miles west of Charleston (distance) (direction) (nearest town)				
WELL PURPOSE: (home/irrigation, municipal, industrial)				
WELL COMPLETION DATA:				
(1) diameter (inches) <u>4</u>				
(2) total depth (feet) <u>535</u>				
(3) static water level (feet) <u>Flowing</u> below top of ground.				
(4) casing <u>PVC</u> <u>525</u> (material) (depth)				
<u>4</u> If telescope see back. (size)				
(5) screen <u>20</u> <u>515</u> (length) (depth to top)				
<u>4</u> <u>PVC</u> (size) (material)				
(6) pump <u>3/4</u> <u>15</u> (HP) (yield gpm)				
<u>elec</u> (type power)				
(7) electric log <u>no</u> (yes or no)				
<u>no</u> (organization running log)				
(8) how well bottom plugged <u>steel</u> <u>plug</u>				
DRILLERS REMARKS:				


DEPT. OF NATURAL RESOURCES
BUREAU OF LAND & WATER RESOURCES

OCT 10 1979

RECEIVED

If well telescopes please sketch and show depths.

GROUND LEVEL

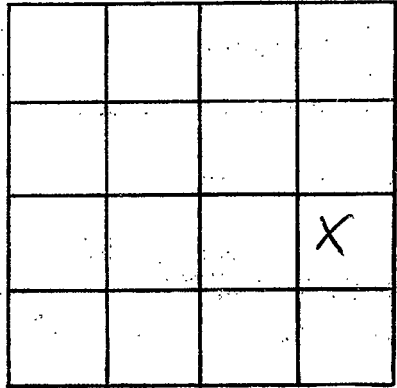

SECTION 7

Please indicate well location X.

ADDITIONAL INFORMATION

If more than one screen, show locations of each on sketch.