

**MISSISSIPPI
BOARD OF WATER COMMISSIONERS**
416 North State Street
Jackson, Mississippi 39201

WATER WELL DRILLERS LOG

Tallahatchie
L 2003
1-18-80

1-18
date well completed

1980 Lipe Well Co.
firm name

Tallahatchie
county well located

LANDOWNER:	description of formations encountered	from	to
<u>Larry G. Cole</u> <u>Payne MS.</u> (mailing address)			

WELL LOCATION:
sec. 26 T 24 N R 2 E
S W
6 miles South of Charleston
(distance) (direction) (nearest town)

WELL PURPOSE:
(home, irrigation, municipal, industrial)

WELL COMPLETION DATA:

- (1) diameter (inches) 4
- (2) total depth (feet) 42
- (3) static water level (feet) 10 below above top of ground.
- (4) casing PVC 34
(material) (depth)
4"
(size) If telescope see back.
- (5) screen 8' 34
(length) (depth to top)
4 PVC
(size) (material)
- (6) pump 3/4 10
(HP) (yield gpm)
elec.
(type power)
- (7) electric log ND
(yes or no)
NDN
(organization running log)
- (8) how well bottom plugged PVC
cap

DEPT. OF NATURAL RESOURCES
BUREAU OF LAND & WATER RESOURCES


MAR 4 - 1980

DRILLERS REMARKS:

RECEIVED

If well telescopes please sketch and show depths.

GROUND LEVEL

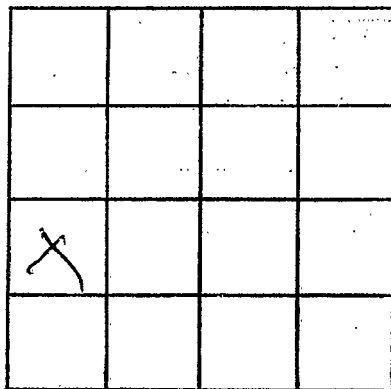

SECTION 26

Please indicate well location X.

ADDITIONAL INFORMATION

If more than one screen,
show locations of each on sketch.