

MISSISSIPPI DEPARTMENT OF ENVIRONMENTAL QUALITY
Bureau of Land and Water Resources

P. O. Box 10631
Jackson, MS 39289-0631
WATER WELL DRILLERS LOG

COUNTY WELL LOCATED TALLAHATCHIE	
WELL NUMBER WELL-2	CODED
L 2008	
DATE WELL COMPLETED 7/1/94	

PERMIT NUMBER
NAME OF DRILLING FIRM LAYNE-CENTRAL

NAME & MAILING ADDRESS OF LANDOWNER HAMP LITTLE		
RT. 2, BOX 371		
CHARLESTON, MS 38921		
WELL LOCATION: SEC	TOWNSHIP	RANGE
33	24 ^(N)	2 ^(E)
DISTANCE	DIRECTION	NEAREST TOWN
1 1/2 Miles	S.W. of	PAYNES
OTHER LANDMARK		
WELL PURPOSE: Home <u>Irrigation</u> , Municipal, Industrial, Fish Pond, etc.		

PUMP DATA		
PUMP TYPE (Circle One): <u>Submersible</u> Turbine, Jet Flowing Well, Other (Describe) _____		
POWER TYPE (Circle One): <u>Electric</u> , Tractor, Diesel, Gasoline, Butane, Other (Describe) _____ H/P <u>15</u>		
Pump Capacity (GPM) 500	No. of Stages 1	Setting Depth 50 FT.
PUMP TEST PUMP NOT TESTED		
Well yielded _____ GPM with a drawdown of _____ ft. after _____ hours of pumping		

WELL DATA		
Well Depth 90'	Casing Diameter (In.) 10"	Casing Length (Ft.) 60'
Type of Casing PVC	Hole Depth 90'	Depth to Static Water Level 12' 5"
TYPE OF COMPLETION: (Circle One or More): <u>Gravel Packed</u> , Underreamed, Telescoped, Natural Development, Open Hole, Other		
Top of Lap Pipe or Reduction in Casing N/A FEET IF TELESCOPED OR MORE THAN ONE SCREEN: USE BACK PAGE		

LOG DATA	
TYPE OF LOG RUN (Circle One): <u>No Log Run</u> , Electric, Gamma Ray, Density, Sonic, Neutron, Other (Describe) _____	
Name of Organization Running Log	

SCREEN DATA		
Diameter - Inches 10"	Length - Feet 30'	Slot Size - Inches .050"
Screen Type PVC		Depth to Bottom - Feet 90'

GEOLOGIC DATA (Office Use Only)			
Surface Elev.	Geologic Unit	Unit Thickness	Depth to Top
Subs. SWL	Date	Analysis	Aquifer Test
Driller's Remarks			

DESCRIPTION OF FORMATIONS ENCOUNTERED	FROM	TO	FORMATIONS (Continued)	FROM	TO
SILTY CLAY	0	12			
BLUE CLAY	12	40			
SAND	40	50			
COURSE SAND & GRAVEL	50	90			

RECEIVED


AUG 29 1994

Dept. of Environmental Quality
Office of Land & Water Resources

IF MORE SPACE IS NEEDED, USE BACK

If well telescopes please sketch and show depths.

GROUND LEVEL

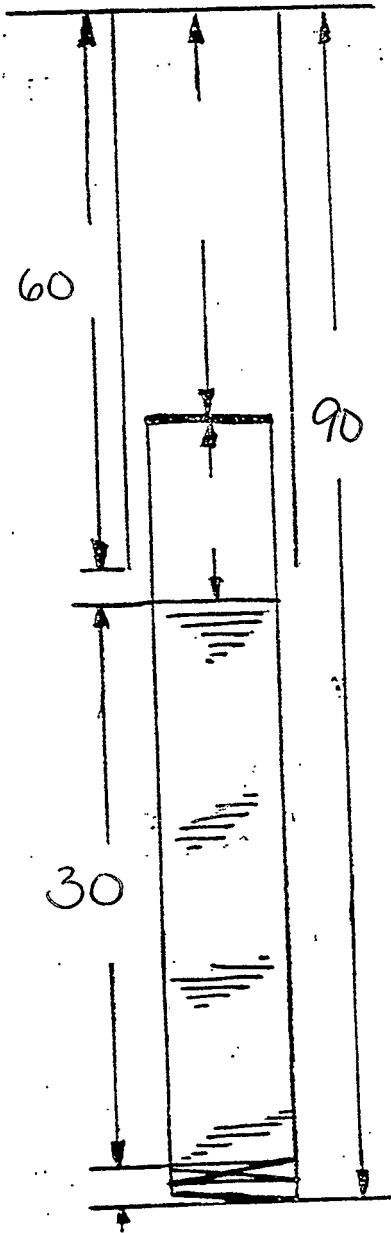

SECTION _____

Please indicate well location X.

ADDITIONAL INFORMATION

show location of each on sketch.