

TALLAHA	TCHIE			MISSISS	SIPPI DEPAR	TMENT OF EN Bureau of	NVIRONMEN Land and Wa	TAL QUALITY ater Resources	
DATE WELL COMP	3.050 PLETED 94	PERMIT NUMBER NAME OF DRILLING FIRM LAYNE—CENTRAL				P. O. Box 10631 Jackson, MS 39289-0631 WATER WELL DRILLERS LOG			
NAME & MAILING ADDRESS OF LANDOWNER					PUMP DATA				
HAMP LITTLE RT. 2, BOX 371					Pt IMP TYPE (Circle One): Judinersible Turbine, Jet Flowing Well,				
CHARLESTON MS 38921					POWFR TYPE (Circle One): Georgia Tractor Diesel, Gasoline, Butane, Other (Describe) H/P Pump Capacity (GPM) No. of Stages Setting Depth				
WELL LOCATION: SEC TOWNSHIP RANG				GE E	Pump Capacity (GPM) No. of Stages Setting Depth 50 FT.				
DISTANCE DIRECTION NEAREST TOWN					PUMP TEST PUMP NOT TESTED				
1½ Miles S.W. of PAYNES					Well yielded GPM with				
OTHER LANDMARK					Wolf ylorded dr w with				
·					a drawdown of ft.				
WELL PURPOSE: Home Irrigation Municipal, Industrial, Fish Pond, etc.					after hours of pumping				
WELL DATA					LOG DATA				
Well Depth	Casing Diameter (In.)		Length (FL) TYPE OF LOG RUN (Circle One): No Log Run,					
1041	12"		69		Electric, Gamma Ray, Density, Sonic, Neutron, Other (Describe)				
Type of Casing	Hole Depth	Depth to St			Name of Organization Running Log				
STEELE 104 12 5" TYPE OF COMPLETION: (Circle One or More):					·				
Gravel Packed Underreamed, Telescoped, Natural Development, Open Hole, Other (Describe)					GEOLOGIC DATA (Office Use Only) Surface Elev. Geologic Unit Unit Thickness Depth to Top				
Top of Lap Pipe or Reduction in Casing				<u> </u>					
LIETELESCOPED OR MORE THAN				N.	Subs. SWL	Date	Analysis	Aquifer Test	
N/A FEET ONE SCREEN: USE BACK PAGE					Driller's Remark	s		<u> </u>	
SCREEN DATA Diameter - Inches Length - Feet Slot Size - Inches									
12"	35 *	31	.050						
		to Bottom - Feet			······································	·			
DOORE			104'						
<u>r</u>									
DESCRIPTION OF FORMATIONS ENCOUNTERED			FROM	то	FORMATIONS (Continued) FROM / TO				
CLAY			0	38	TO THE PROPERTY OF THE PARTY OF				
FINE SAND			_38	49				RIB	
COURSE			<u>49</u>	60	i k		- 63		
BIG GRAVEL			60 100	100 104	<u> </u>				
CLAY .			104	104		AUG 2	9 1994		
			·		Deat of France and Overline				
•					Dept. of Environmental Quality Office of Land & Water Resources				
					Offic	O UI LANU O	valer nest	JUICED	
					IF MORE SPACE I	S NEEDED, USE BA	ACK	_	
	100		4	<u> </u>					

, ;

If well telescopes please sketch and show depths.

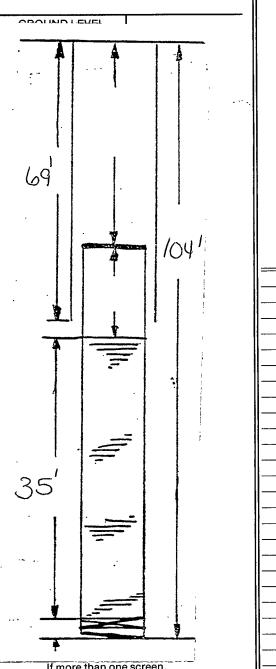

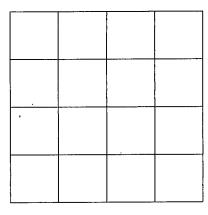

Please indicate well location X.

ADDITIONAL INFORMATION

SECTION ____

If more than one screen, show location of each on sketch.