

Zallahatchie  
TALOS

MISSISSIPPI BOARD OF WATER COMMISSIONERS

CODED

M 2  
3-24-66

James R. Lipe  
WATER WELL DRILLERS LOG

Zallahatchie

Date: 3/24, 1966, Driller: York Taylor County ~~Franklin~~  
(Name)

(1) Owner of Land: Mark Mitchell  
(Name)  
Sealee  
(Address)

(2) Location: 1 <sup>24</sup>/<sub>4</sub>, 3 <sup>3</sup>/<sub>4</sub>, Sec. 1 <sup>24</sup>/<sub>4</sub>, 3 <sup>3</sup>/<sub>4</sub>,  
(distance) West of Sealee (direction) (Nearest Town)

(3) Topography: Hilly  
(Hilly) (Flat) (Level)

(4) Purpose of Well: Dom  
(Domestic Irrigation  
Municipal, Industrial, Other)

Description & Color of Materials Sand, Clay, Red Clay, Shell, etc.	Thick- ness Feet	Depth Feet
Clay	0	75
Chap Red clay	75	130
granul. sand	130	160
Sand	160	190
ry sand	190	209

Information upon completion of well:

(1) Diameter 2 inches.

(2) Total Depth 209' feet.

(3) Water Level 175 feet below top of ground.

(4) Cased to 200, Size 2"


(5) Screen: Size 1/4, Length 6'

(6) Were any formations sealed against pollution?  
\_\_\_\_\_ yes, \_\_\_\_\_ no.

If YES depth of formation \_\_\_\_\_

Why \_\_\_\_\_

Drillers Remarks: \_\_\_\_\_

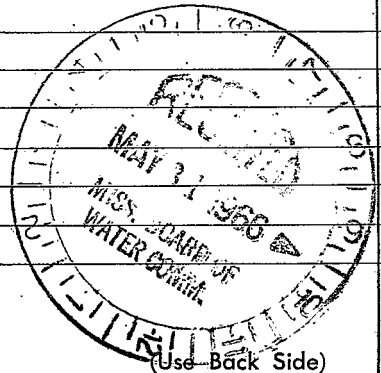

Well No.

1000