

TALLAHATCHIE
M5
10-10-72

MISSISSIPPI
BOARD OF WATER COMMISSIONERS
416 North State Street
Jackson, Mississippi 39201

CODED

WATER WELL DRILLERS LOG

10-10 1972 James R. Lipe Tallahatchie
date well completed firm name county well located

LANDOWNER: Mack
TIMMONS
Charleston Miss.
(mailing address)

description of formations encountered	from	to
clay	0	20
cl	20	40
sand	40	60
cl	60	80
GRAVEL	80	100
cl	100	120
sand and clay	120	140
sand	140	160
cl	160	182

WELL LOCATION:
sec 9 T24N R3E
S W
4 miles S.E. of Charleston
(distance) (direction) (nearest town)

WELL PURPOSE: HOME
(home, irrigation, municipal, industrial)

WELL COMPLETION DATA:
(1) diameter (inches) 4"
(2) total depth (feet) 182
(3) static water level (feet) 120 below top of ground.
(4) casing PVC 172 (material) (depth)
4 (size) if telescope see back.
(5) screen 10 172 (length) (depth to top)
4 PVC (size) (material)
(6) pump 3/4 15 (HP) (yield gpm).
Elec (type power)
(7) electric log no (yes or no)
no (organization running log)
(8) how well bottom plugged PVC plug


CODED

DRILLERS REMARKS:

1972
MAY 1972
MAY 1972

If well telescopes please sketch and show depths.

GROUND LEVEL

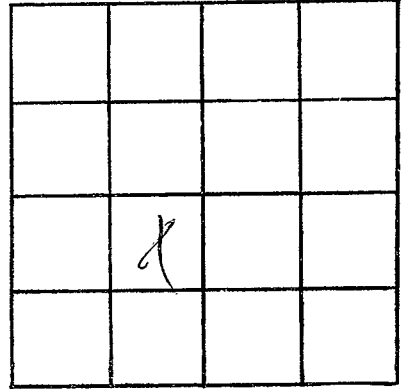

SECTION 9

Please indicate well location X.

ADDITIONAL INFORMATION

If more than one screen,
show locations of each on sketch.