

CODED

TALLAHATCHIE
M6
10-20-72

MISSISSIPPI
BOARD OF WATER COMMISSIONERS
416 North State Street
Jackson, Mississippi 39201

WATER WELL DRILLERS LOG

10-20 date well completed 1972 JAMES R. LIPE firm name Tallahatchie county well located

LANDOWNER: Iva Carpenter
Charleston
MISS.
(mailing address)

WELL LOCATION:
sec 17 T 24 N R 3 E
5 miles S.E. of Charleston
(distance) (direction) (nearest town)

WELL PURPOSE: HOME
(home, irrigation, municipal, industrial)

- WELL COMPLETION DATA:
- (1) diameter (inches) 4
 - (2) total depth (feet) 102
 - (3) static water level (feet) 120 below top of ground.
 - (4) casing PVC, 159 (material) (depth)
4 (size) if telescope see back.
 - (5) screen 10, 159 (length) (depth to top)
4 (size) PVC (material)
 - (6) pump 3/4, 10 (HP) (yield gpm)
Elec. (type power)
 - (7) electric log NI (yes or no)
NI (organization running log)
 - (8) how well bottom plugged PVC PLUG

description of formations encountered	from	to
Top Soil	0	20
sand	20	40
"	40	60
gravel	60	80
clay	80	100
sand and clay	100	120
sand	120	162

CODED


DRILLERS REMARKS:

NOV - 1 1972

MISS. BD. OF
WATER COMMISSIONERS

If well telescopes please sketch and show depths.

GROUND LEVEL

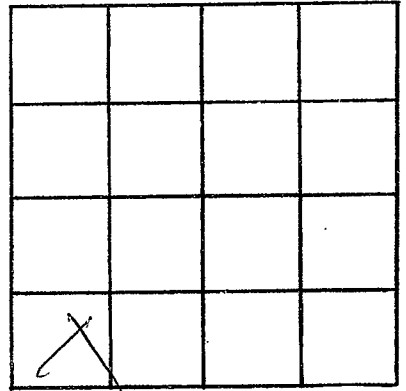

SECTION 17

Please indicate well location X.

ADDITIONAL INFORMATION

If more than one screen,
show locations of each on sketch.