

TALLAHATCHIE

M9

2-1-73

MISSISSIPPI BOARD OF WATER COMMISSIONERS
416 North State Street
Jackson, Mississippi 39201

CODED

WATER WELL DRILLERS LOG

2-1
date well completed

1973 James R. Lipe
firm name

Tallahatchie
county well located

LANDOWNER:
J. T. Elliott
Scobey Miss.
(mailing address)

description of formations encountered	from	to
	Top Soil	0
Sand	20	40
Gravel	40	60
Gravel	60	80
Gravel	80	100
Sand	100	180

WELL LOCATION:
sec. 21 T. 24 N. R. 3 E. S. W.
6 miles S. E. of Charleston
(distance) (direction) (nearest town)

WELL PURPOSE: HOME
(home, irrigation, municipal, industrial)

- WELL COMPLETION DATA:
- (1) diameter (inches) 4
 - (2) total depth (feet) 180
 - (3) static water level (feet) 100 below above top of ground.
 - (4) casing PVC 172
(material) (depth)
 - (size) 4 if telescope see back.
 - (5) screen 8 172
(length) (depth to top)
 - (size) 4 PVC (material)
 - (6) pump 3/4 10
(HP) (yield gpm)
 - Elec.
(type power)
 - (7) electric log NO
(yes or no)
 - NO
(organization running log)
 - (8) how well bottom plugged PVC
plug


CODED

SEE 2 1033

DRILLERS REMARKS:

If well telescopes please sketch and show depths.

GROUND LEVEL

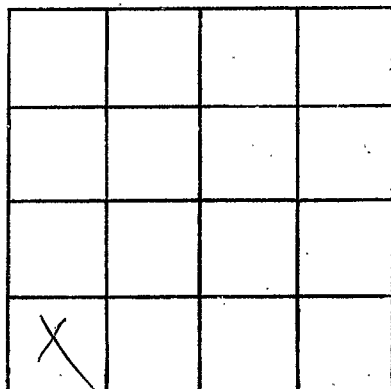

SECTION 21

Please indicate well location X.

ADDITIONAL INFORMATION

If more than one screen,
show locations of each on sketch.