

CODED

MISSISSIPPI
BOARD OF WATER COMMISSIONERS
416 North State Street
Jackson, Mississippi 39201

Zallahatchie
M 13
2-26-69

WATER WELL DRILLERS LOG

2. 26 1969 James B. Life Talla
date well completed firm name county well located

LANDOWNER: Molly T. Williams
Talla Toba
Missi.
(mailing address)

description of formations encountered	from to	
	feet	feet
<u>Clay</u>	<u>0</u>	<u>20</u>
<u>Sand and gravel</u>	<u>20</u>	<u>40</u>
<u>black clay</u>	<u>40</u>	<u>60</u>
<u>ll ll</u>	<u>60</u>	<u>80</u>
<u>good sand</u>	<u>80</u>	<u>100</u>
<u>ll ll</u>	<u>100</u>	<u>119</u>

WELL LOCATION:
sec. 2 T. 24 (N) R. 3 (E)
6 miles South of Charleston
(distance) (direction) (nearest town)

WELL PURPOSE: Home
(home, irrigation, municipal, industrial)

WELL COMPLETION DATA:

- (1) diameter (inches) 4"
- (2) total depth (feet) 119
- (3) static water level (feet) 40 below top of ground.
- (4) Plastic 103
(material) (depth)
- (5) screen 16" 103
(length) (depth to top)
4" Plastic
(size) (material)
- (6) pump 3/4 10
(HP) (yield gpm)
elec.
(type power)
- (7) electric log no
(yes or no)

(organization running log)

(8) how well bottom plugged 4" Plug


DRILLERS REMARKS:

28 1969

MISSISSIPPI BOARD OF WATER COMMISSIONERS

If well telescopes please sketch and show depths.

GROUND LEVEL

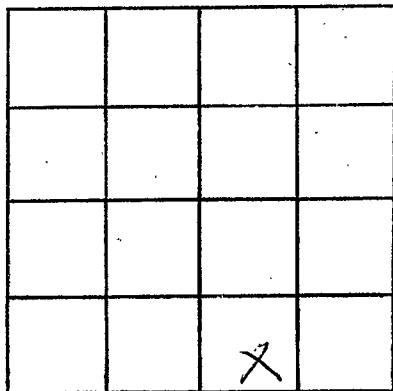

SECTION 2

Please indicate well location X.

ADDITIONAL INFORMATION

If more than one screen,
show locations of each on sketch.