

CODED

Tallahatchie
M 14
10-13-69

MISSISSIPPI
BOARD OF WATER COMMISSIONERS
416 North State Street
Jackson, Mississippi 39201

WATER WELL DRILLERS LOG

Oct 13 1969 James R. Lipe Tallahatchie
date well completed firm name county well located

LANDOWNER:

G. L. Ross
Charleston Miss.
(mailing address)

description of formations encountered

from to

Clay	0	20
"	20	40
sand	40	60
Gravel	60	80
"	80	100
sand	100	120
"	120	140
"	140	165

WELL LOCATION:

sec. 15 T 24 N R 3 E
6 miles S.E. of Charleston
(distance) (direction) (nearest town)

WELL PURPOSE: home
(home, irrigation, municipal, industrial)

WELL COMPLETION DATA:

- (1) diameter (inches) 4
- (2) total depth (feet) 165
- (3) static water level (feet) 112 below top of ground.
- (4) casing Plastic 157 (material) (depth)
4 (size) if telescope see back.
- (5) screen 8 157 (length) (depth to top)
4 Plastic (size) (material)
- (6) pump 3/4 10 (HP) (yield gpm)
Elec. (type power)
- (7) electric log no (yes or no)
no (organization running log)
- (8) how well bottom plugged with Plastic Plug


DRILLERS REMARKS:

OCT 20 1969

MISS. BR. OF
WATER COMMISSIONERS

If well telescopes please sketch and show depths.

GROUND LEVEL

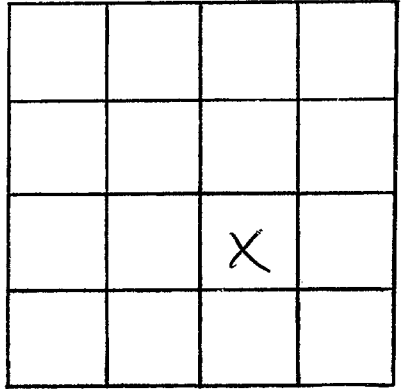

SECTION 15

Please indicate well location X.

ADDITIONAL INFORMATION

If more than one screen, show locations of each on sketch.