

Tallahatchie
 M 15
 3-20-68

MISSISSIPPI
 BOARD OF WATER COMMISSIONERS
 416 North State Street
 Jackson, Mississippi 39201

Hughes
 C264
 CODED
 CODED

WATER WELL DRILLERS LOG

March 20, 19 68 Layne-Central Company
 date well completed firm name

Tallahatchie
 county well located

LANDOWNER: James Artman

description of formations
 encountered

from to

Rede clayton

0 25

Blue clay

45 74

Charleston, Mississippi
 (mailing address)

Coarse sand

74 91

Hard clay

91 92

WELL LOCATION:

sec. 3 T 24 N R 3 E
 S W

2-1/2 miles south of Charleston
 (distance) (direction) (nearest town)

WELL PURPOSE: irrigation
 (home, irrigation, municipal, industrial)

WELL COMPLETION DATA:

(1) diameter (inches) 12 x 10

(2) total depth (feet) 92

(3) static water level (feet) below above
 top of ground.

(4) casing steel, 77'
 (material) (depth)

12" if telescope see back.
 (size)

(5) screen 13', 92'
 (length) (depth to top)

10", Armco
 (size) (material)

(6) pump 20, 250
 (HP) (yield gpm)


engine
 (type power)

(7) electric log no
 (yes or no)

(organization running log)


(8) how well bottom plugged plate

DRILLERS REMARKS:

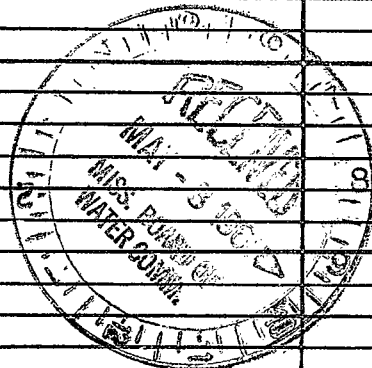

If well telescopes please sketch and show depths.

GROUND LEVEL

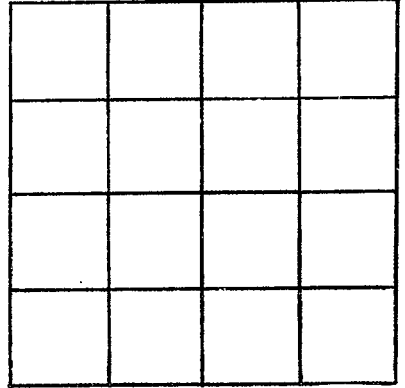

SECTION _____

Please indicate well location X.

ADDITIONAL INFORMATION

If more than one screen,
show locations of each on sketch.