

TALLAHATCHIE
M 18
5-14-73

MISSISSIPPI
BOARD OF WATER COMMISSIONERS
416 North State Street
Jackson, Mississippi 39201
WATER WELL DRILLERS LOG

CODED

5-14 date well completed
1973 James R. Lipe firm name
Tallahatchie county well located

LANDOWNER:
Ernest Carlisle
Charleston Miss.
(mailing address)

WELL LOCATION:
sec. 22 T 24 N R 3 E W
10 miles S. E. of Charleston
(distance) (direction) (nearest town)

WELL PURPOSE: Home
(home, irrigation, municipal, industrial)

- WELL COMPLETION DATA:
- (1) diameter (inches) 4
 - (2) total depth (feet) 181
 - (3) static water level (feet) 130 below top of ground.
 - (4) casing PVC 171
(material) (depth)
4 (size) if telescope see back.
 - (5) screen 10 171
(length) (depth to top)
4 PVC
(size) (material)
 - (6) pump 3/4 10
(HP) (yield gpm)
Elec.
(type power)
 - (7) electric log NO
(yes or no)
NO
(organization running log)
 - (8) how well bottom plugged PVC Plug

description of formations encountered	from	to
Red Clay	0	20
cc	20	40
red sand	40	60
gravel	60	80
cc	80	100
sand and gravel	100	120
white sand	120	181


CODED

JUN 7 1973

DRILLERS REMARKS:

If well telescopes please sketch and show depths.

GROUND LEVEL

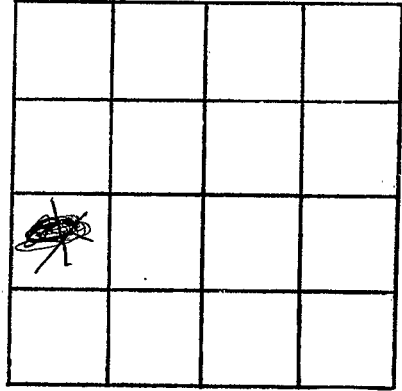

SECTION 22

Please indicate well location X.

ADDITIONAL INFORMATION

A series of horizontal lines for writing additional information.

If more than one screen, show locations of each on sketch.