

TALLAHATCHIE  
M 19  
7-73

MISSISSIPPI  
BOARD OF WATER COMMISSIONERS  
416 North State Street  
Jackson, Mississippi 39201

CODED

WATER WELL DRILLERS LOG

19 73 James R. Lipe Tallahatchie  
date well completed firm name county well located

LANDOWNER:

Roman Elliott  
Charleston Miss,  
(mailing address)

description of formations encountered

from to

red clay	0	20
ll ll	20	40
ll ll	40	60
Gravel	60	80
ll	80	100
ll	100	120
White Sand	120	140
ll ll	140	180

WELL LOCATION:

sec. 17 T. 24 (N) R. 3 (E)  
S  
W  
8 miles S.E. of Charleston  
(distance) (direction) (nearest town)

WELL PURPOSE:

(home, irrigation, municipal, industrial)

WELL COMPLETION DATA:

- (1) diameter (inches) 4
- (2) total depth (feet) 180
- (3) static water level (feet) 160 below above top of ground.
- (4) casing PVC, 170,  
(material) (depth)  
4 If telescope see back.  
(size)
- (5) screen 10, 170  
(length) (depth to top)  
4, PVC  
(size) (material)
- (6) pump 3/4, 10  
(HP) (yield gpm)  
elec  
(type power)
- (7) electric log no  
(yes or no)  
no  
(organization running log)
- (8) how well bottom plugged PVC  
PIUG


CODED

DRILLERS REMARKS:

JUL 5 1973

If well telescopes please sketch and show depths.

GROUND LEVEL

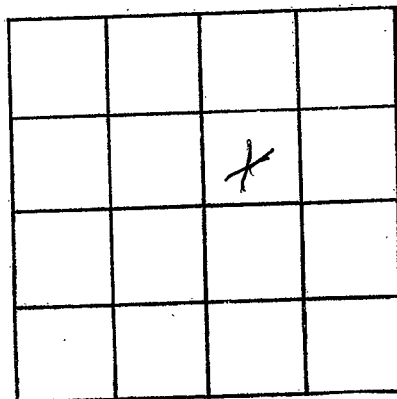

SECTION 17

Please indicate well location X.

ADDITIONAL INFORMATION

If more than one screen, show locations of each on sketch.