

TALLAHATCHIE  
M 20  
6-12-73

MISSISSIPPI  
BOARD OF WATER COMMISSIONERS  
416 North State Street  
Jackson, Mississippi 39201

CODED

WATER WELL DRILLERS LOG

6-12 1973 James R. Lipe Tallahatchie  
date well completed firm name county well located


LANDOWNER:	description of formations encountered	from	to
Corinth Baptist Church Charleston Miss. (mailing address)		red clay " " " " gravel " " white sand " "	0 20 40 60 80 100 120 140
WELL LOCATION: sec. 17 T. 24 N. R. 3 E 8 miles S. E. of Charleston (distance) (direction) (nearest town)			
WELL PURPOSE: (home, irrigation, municipal, industrial)			
WELL COMPLETION DATA:			
(1) diameter (inches) 4			
(2) total depth (feet) 180			
(3) static water level (feet) 100 below top of ground.			
(4) casing PVC, 170 (material), (depth) 4 (size) if telescope see back.			
(5) screen 10, 170 (length), (depth to top) 4, PVC (size), (material)			
(6) pump 3/4, 10 (HP), (yield gpm) elec. (type power)			
(7) electric log no (yes or no) no (organization running log)			
(8) how well bottom plugged PVC PVC			
DRILLERS REMARKS:			

CODED

JUL 5 1973

If well telescopes please sketch and show depths.

GROUND LEVEL

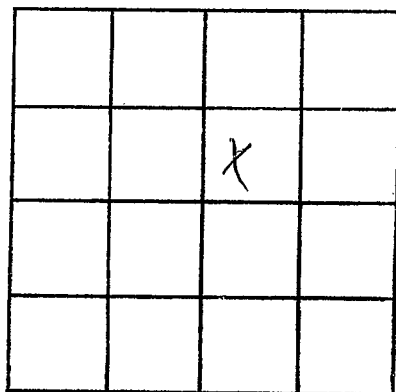

SECTION

17

Please indicate well location X.

ADDITIONAL INFORMATION

If more than one screen,  
show locations of each on sketch.