

TALLAHATCHIE

M 21

6-11-73

MISSISSIPPI BOARD OF WATER COMMISSIONERS
416 North State Street
Jackson, Mississippi 39201

CODED

WATER WELL DRILLERS LOG

6-11
date well completed

1973 James R. Lipe
firm name

Tallahatchie
county well located

LANDOWNER:

Mather Greer
Charleston Miss.
(mailing address)

description of formations encountered

	from	to
red clay	0	20
" sand	20	40
" "	40	60
gravel	60	80
"	80	100
sand	100	120
white sand	120	162

WELL LOCATION:

sec. 27 T 24 N R 3 E
S W

10 miles S. E. of Charleston
(distance) (direction) (nearest town)

WELL PURPOSE:

(home) irrigation, municipal, industrial

WELL COMPLETION DATA:

- (1) diameter (inches) 4
- (2) total depth (feet) 162
- (3) static water level (feet) 100 below top of ground.
- (4) casing PVC 154
(material) (depth)
4 (size) if telescope see back.
- (5) screen 8 154
(length) (depth to top)
4 PVC
(size) (material)
- (6) pump 3/4 12
(HP) (yield gpm)
elec.
(type power)
- (7) electric log No
(yes or no)
No
(organization running log)
- (8) how well bottom plugged PVC
plug


CODED

DRILLERS REMARKS:

JUL 5 1973

If well telescopes please sketch and show depths.

GROUND LEVEL

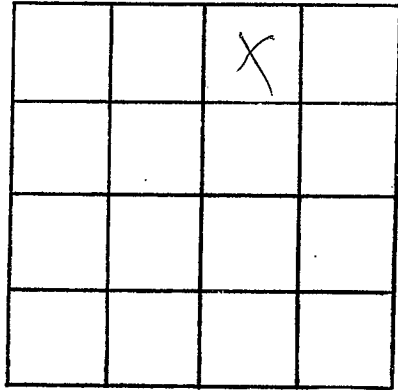

SECTION 27

Please indicate well location X.

ADDITIONAL INFORMATION

A series of horizontal lines for writing additional information.

If more than one screen, show locations of each on sketch.