

Tallahatchie

M23

9-25-73

MISSISSIPPI
 BOARD OF WATER COMMISSIONERS
 416 North State Street
 Jackson, Mississippi 39201

CODED

WATER WELL DRILLERS LOG

9-25

1973 Life Well Co. Tallahatchie

date well completed

firm name

county well located

LANDOWNER:
 David Miller
 Charleston Miss,
 (mailing address)

description of formations encountered	from	to
TOP Soil	0	20
Sand	20	40
CL	40	60
CLAY	60	80
clay and sand	80	100
CL CL CL	100	120
CL CL CL	120	140
CL CL CL	140	153

WELL LOCATION:
 sec. 30 T. 240 (N) R. 3 (E)
 S W
 8 miles S. E. of Charleston
 (distance) (direction) (nearest town)

WELL PURPOSE:
 (home) Irrigation, municipal, industrial


- WELL COMPLETION DATA:
- (1) diameter (inches) 4
 - (2) total depth (feet) 153
 - (3) static water level (feet) 105 below top of ground.
 - (4) casing PVC 145
 (material) (depth)
4 if telescope see back.
 (size)
 - (5) screen 10 145
 (length) (depth to top)
4 PVC
 (size) (material)
 - (6) pump 3/4 10
 (HP) (yield gpm)
elec
 (type power)
 - (7) electric log NO
 (yes or no)
NO
 (organization running log)
 - (8) how well bottom plugged PVC
PVC

DRILLERS REMARKS:

GET 9 10 73

If well telescopes please sketch and show depths.

GROUND LEVEL

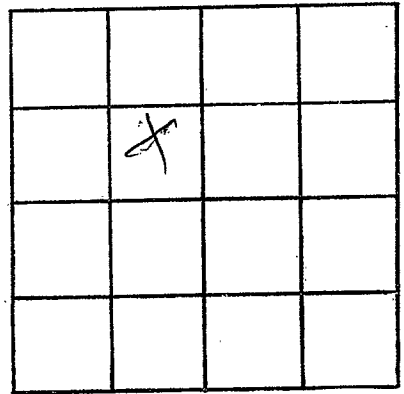

SECTION 30

Please indicate well location X.

ADDITIONAL INFORMATION

If more than one screen,
show locations of each on sketch.