

Tallahatchie
M 27
4-17-74

MISSISSIPPI
BOARD OF WATER COMMISSIONERS
416 North State Street
Jackson, Mississippi 39201

CODED

WATER WELL DRILLERS LOG

4-17
date well completed

1974 Lipe well Co.
firm name

Tallahatchie
county well located

LANDOWNER:
Frank Roberson
Charleston Miss.
(mailing address)


description of formations encountered	from	to
TOP soil	0	20
Clay	20	40
red sand	40	60
" "	60	80
Pea gravel	80	100
" "	100	120
blue clay	120	140
" "	140	160
" "	160	180
sand	180	200
" "	200	210

WELL LOCATION:
sec 21 T 24 N R 3 E
7 miles S. E. of Charleston
(distance) (direction) (nearest town)

WELL PURPOSE:
(home irrigation, municipal, industrial)

- WELL COMPLETION DATA:
- (1) diameter (inches) 4
 - (2) total depth (feet) 210
 - (3) static water level (feet) 100 below top of ground.
 - (4) casing PVC 200 (material) (depth)
 - 4 (size) if telescope see back.
 - (5) screen 10 200 (length) (depth to top)
 - 4 PVC (size) (material)
 - (6) pump 3/4 10 (HP) (yield gpm)
 - elec. (type power)
 - (7) electric log no (yes or no)
 - no (organization running log)
 - (8) how well bottom plugged PVC Plug

CODED

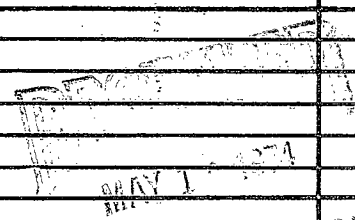


DRILLERS REMARKS:

MISS. BD. OF WATER COMMISSIONERS

If well telescopes please sketch and show depths.

GROUND LEVEL

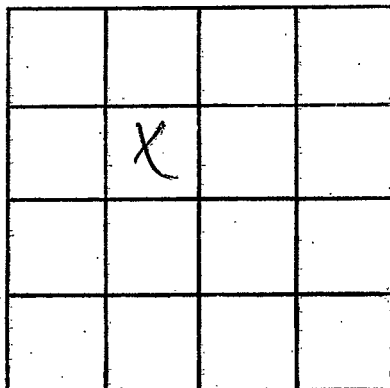

SECTION 21

Please indicate well location X.

ADDITIONAL INFORMATION

If more than one screen, show locations of each on sketch.