

TALLAHATCHIE
M29
6-26-74

MISSISSIPPI
BOARD OF WATER COMMISSIONERS
416 North State Street
Jackson, Mississippi 39201

WATER WELL DRILLERS LOG

CODED

6-26 1974 Lipe Well Co. Tallahatchie
date well completed firm name county well located

LANDOWNER:

H. L. Taylor
Charleston Miss.
(mailing address)

description of formations encountered

from to

TOP Soil	0	20
Sand	20	40
Gravel	40	60
"	60	80
Sand	80	100
"	100	135

WELL LOCATION:

sec. 33 T. 24 N. R. 3 E
S W
10 miles S. E. of Charleston
(distance) (direction) (nearest town)

WELL PURPOSE:

(home, irrigation, municipal, industrial)

WELL COMPLETION DATA:

- (1) diameter (inches) 4
- (2) total depth (feet) 135
- (3) static water level (feet) 80 below top of ground.
- (4) casing PVC, 125 (material), (depth)
4 (size) if telescope see back.
- (5) screen 10, 125 (length), (depth to top)
4, PVC (size), (material)
- (6) pump 3/4, 10 (HP), (yield gpm)
elec. (type power)
- (7) electric log no (yes or no)
no (organization running log)
- (8) how well bottom plugged PVC Plug


CODED

DRILLERS REMARKS:

RECEIVED
JUL - 3 1974

If well telescopes please sketch and show depths.

GROUND LEVEL

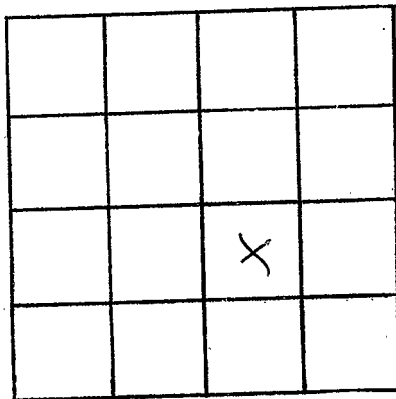

SECTION 33

Please indicate well location X.

ADDITIONAL INFORMATION

If more than one screen, show locations of each on sketch.