

Tallahatchie
M31
9-17-74

MISSISSIPPI
BOARD OF WATER COMMISSIONERS
416 North State Street
Jackson, Mississippi 39201

WATER WELL DRILLERS LOG

CODED

9-17 1974 LIPE WELL Co Tallahatchie
date well completed firm name county well located

LANDOWNER:
Morris Rutledge
Charleston Miss.
(mailing address)

WELL LOCATION:
sec. 21 T. 24 N. R. 3 E
8 miles S. E. of Charleston
(distance) (direction) (nearest town)

WELL PURPOSE:
(home, irrigation, municipal, industrial)

WELL COMPLETION DATA:
(1) diameter (inches) 4"
(2) total depth (feet) 244
(3) static water level (feet) 102 below top of ground.
(4) casing PVC 234 (material) (depth)
if telescope see back.
(5) screen 11 234 (length) (depth to top)
4 PVC (size) (material)
(6) pump 3/4 50 (HP) (yield gpm)
elec. (type power)
(7) electric log no (yes or no)
no (organization running log)
(8) how well bottom plugged PVC
P169

description of formations encountered	from	to
Top soil	0	20
red clay	20	40
" sand	40	60
gravel	60	80
" "	80	100
blue clay	100	120
" "	120	140
" "	140	160
sand and clay	160	180
" "	180	200
" "	200	220
" "	220	244


RECEIVED
NOV - 5 1974

DRILLERS REMARKS:

MISS. BD. OF WATER COMMISSIONERS

If well telescopes please sketch and show depths.

GROUND LEVEL

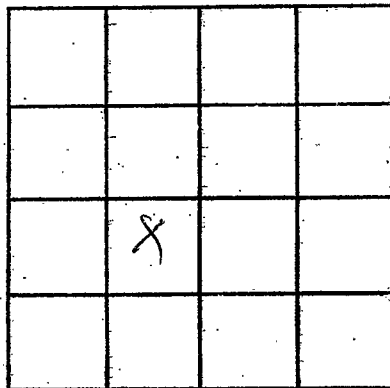

SECTION 21

Please indicate well location X.

ADDITIONAL INFORMATION

If more than one screen,
show locations of each on sketch.