

Tallahatchie
 M 32
 11-23-79

MISSISSIPPI
 BOARD OF WATER COMMISSIONERS
 416 North State Street
 Jackson, Mississippi 39201

CODED

WATER WELL DRILLERS LOG

11-23 1974 Like Well Co. Tallahatchie
 date well completed firm name county well located

LANDOWNER: W. A. Ward
 Charleston
 Miss.
 (mailing address)

WELL LOCATION:
 sec. 22 T 24 N R 3 E
 S W
 8 miles S.E. of Charleston
 (distance) (direction) (nearest town)

description of formations encountered	from	to
TOP soil	0	20
red sand	20	40
gravel	40	60
cc	60	80
sand	80	100
white clay and sand	100	120
sand	120	140
white sand	140	167

WELL PURPOSE:
 (home, irrigation, municipal, industrial)

WELL COMPLETION DATA:

(1) diameter (inches) 4

(2) total depth (feet) 167

(3) static water level (feet) 120 below above top of ground.

(4) casing PVC 157 (material) (depth)
 4 (size) if telescope see back.

(5) screen 10 157 (length) (depth to top)
 4 PVC (size) (material)

(6) pump 3/4 10 (HP) (yield gpm)
 elec. (type power)

(7) electric log NO (yes or no)
 NO (organization running log)

(8) how well bottom plugged PVC Plug

DRILLERS REMARKS:


CODED

RECEIVED

DEC 5 1974

If well telescopes please sketch and show depths.

GROUND LEVEL

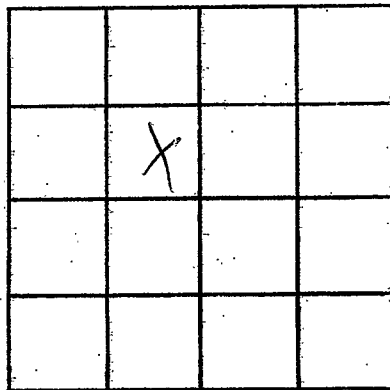

SECTION 22

Please indicate well location X.

ADDITIONAL INFORMATION

If more than one screen, show locations of each on sketch.