

TALLAH
M 33

WATER WELL DRILLERS LOG

Date 2-18, 1962, Driller: J B CAPOD County TALLAHUNEE

2-18-62
(Name)

(1) Owner of Land: Mrs Rosa R Shaton
(Name)

Route 1 Scoby Miss
(Address)

(2) Location: SW 1/4, 1/4, Sec. 21 T R24N

7 miles west, of Scoby
(distance) (direction) (Nearest town)

(3) Topography: (Hilly) (Flat) (Level)

(4) Purpose of Well: HOME
(Domestic Irrigation
Municipal, Industrial, Other)

Description & Color of Materials Sand, Clay, Red Clay, Shell, etc.	Thick- ness Feet	Depth Feet
---	------------------------	---------------

<u>Bro Clay</u>	<u>0</u>	<u>30</u>
<u>Gravel</u>	<u>30</u>	<u>55</u>
<u>Sand</u>	<u>55</u>	<u>65</u>

Information upon completion of well:

(1) Diameter 2 inches.

(2) Total Depth 65 feet.

(3) Water Level 45 feet below top of ground.

(4) Cased to 65, Size 2"



(5) Screen: Size 1 1/2, Length 5 FT

(6) Were any formations sealed against pollution?
no

If YES depth of formation _____

Why _____

Drillers Remarks: _____

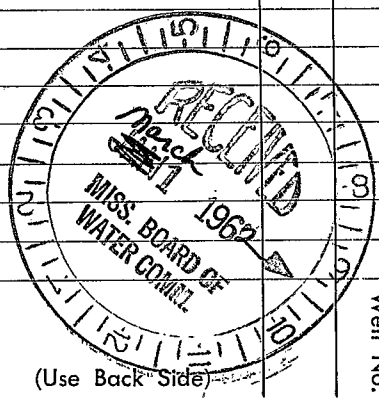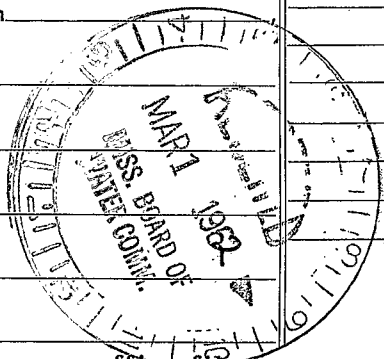

CODED

(Use Back Side)

Well No. _____

Retain this copy for your office files.

