

**Tallahatchie**  
**M 34**  
**1/75**

**MISSISSIPPI**  
**BOARD OF WATER COMMISSIONERS**  
 416 North State Street  
 Jackson, Mississippi 39201

**WATER WELL DRILLERS LOG**

date well completed 1975 Life Well Co firm name Tallahatchie county well located

**LANDOWNER:**  
Woodrow Tinnyson  
Charleston, Miss.  
 (mailing address)

description of formations encountered	from	to
TOP Soil	0	20
red clay	20	40
cl Sand	40	60
Gravel	60	80
"	80	100
Sand and Gravel	100	120
White Sand	120	180

**WELL LOCATION:**  
 sec. 7 T 24 N R 3 E  
 S W  
3 miles S. E. of Charleston  
 (distance) (direction) (nearest town)

**WELL PURPOSE:**  
 (home) irrigation, municipal, industrial

- WELL COMPLETION DATA:**
- (1) diameter (inches) 4
  - (2) total depth (feet) 180
  - (3) static water level (feet) 80 below above top of ground.
  - (4) casing PVC 170  
 (material) (depth)  
4 if telescope see back.  
 (size)
  - (5) screen 10 170  
 (length) (depth to top)  
4 PVC  
 (size) (material)
  - (6) pump 3/4 10  
 (HP) (yield gpm)  
elec  
 (type power)
  - (7) electric log no  
 (yes or no)  
no  
 (organization running log)
  - (8) how well bottom plugged PVC  
plug


**REGISTERED**  
**FEB 5 1975**

**MISS. BD. OF WATER**

**DRILLERS REMARKS:**

If well telescopes please sketch and show depths.

GROUND LEVEL

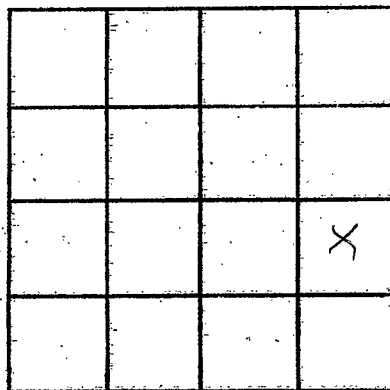

SECTION 7

Please indicate well location X.

ADDITIONAL INFORMATION

If more than one screen,  
show locations of each on sketch.