

Tallahatchie
M 35
1-24-75

MISSISSIPPI
BOARD OF WATER COMMISSIONERS
416 North State Street
Jackson, Mississippi 39201

WATER WELL DRILLERS LOG

1-24-75 date well completed 1975 Lipe Well Co. firm name Tallahatchie county well located

LANDOWNER:
S. M. Mullen
Charleston Miss.
(mailing address)

| description of fomations encountered | from | to |
|--------------------------------------|------|-----|
| Top soil | 0 | 20 |
| red clay | 20 | 40 |
| cc sand | 40 | 60 |
| Gravel | 60 | 80 |
| " | 80 | 100 |
| " | 100 | 120 |
| white clay | 120 | 140 |
| sand | 140 | 163 |

WELL LOCATION:
sec. 26 T 24 N R 3 E S W
8 miles S. E. of Charleston
(distance) (direction) (nearest town)

WELL PURPOSE:
(home, irrigation, municipal, industrial)

WELL COMPLETION DATA:
(1) diameter (inches) 4"
(2) total depth (feet) 163
(3) static water level (feet) 90 below top of ground.
(4) casing PVC 153 (material) (depth)
4 If telescope see back. (size)
(5) screen 10 153 (length) (depth to top)
4 PVC (size) (material)
(6) pump 3/4 10 (HP) (yield gpm)
elec. (type power)
(7) electric log No (yes or no)
No (organization running log)
(8) how well bottom plugged PVC plug

CODED

RECEIVED


FEB 5 - 1975

DRILLERS REMARKS:

BD. OF WATER COMMISSIONERS

If well telescopes please sketch and show depths.

GROUND LEVEL

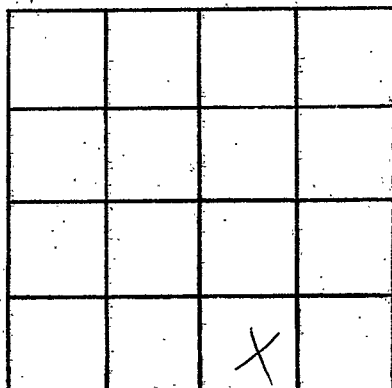

SECTION 26

Please indicate well location X.

ADDITIONAL INFORMATION

If more than one screen, show locations of each on sketch.