

Tallahatchie
M 37
5-8-75

MISSISSIPPI
BOARD OF WATER COMMISSIONERS
416 North State Street
Jackson, Mississippi 39201

WATER WELL DRILLERS LOG

CODED

5-8 1975 Lipe Well Co Tallahatchie
date well completed firm name county well located

LANDOWNER:
Isam White
Sobey Miss.
(mailing address)

description of formations encountered	from	to
Clay	0	20
sand	20	40
gravel	40	60
"	60	80
sand and gravel	80	100
" " "	100	130
sand	130	140

WELL LOCATION:
sec. 25 T 24 N R 3 E 15F
S W
5 miles west of Sobey
(distance) (direction) (nearest town)

WELL PURPOSE:
(home, irrigation, municipal, industrial)

WELL COMPLETION DATA:

(1) diameter (inches) 4

(2) total depth (feet) 140

(3) static water level (feet) 80 below top of ground.

(4) casing PVC 130
(material) (depth)
4 (size) if telescope see back.

(5) screen 10 130
(length) (depth to top)
4 PVC
(size) (material)

(6) pump 3/4 10
(HP) (yield gpm)
elec
(type power)

(7) electric log no
(yes or no)
no
(organization running log)

(8) how well bottom plugged PVC
0.70


CODED
Well OK

RECEIVED
JUL 14 1975

DRILLERS REMARKS:

If well telescopes please sketch and show depths.

GROUND LEVEL

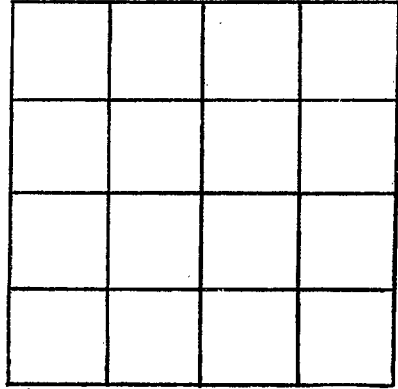

SECTION _____

Please indicate well location X.

ADDITIONAL INFORMATION

If more than one screen,
show locations of each on sketch.