

Tallahatchie
M 39
7-23-75

MISSISSIPPI
BOARD OF WATER COMMISSIONERS
416 North State Street
Jackson, Mississippi 39201


CODED

WATER WELL DRILLERS LOG

7-23 date well completed 1975 LIPE well Co. firm name Tallahatchie county well located

LANDOWNER:	description of formations encountered	from	to
Gulias Rideout Charleston Miss. (mailing address)			
	red sand	20	40
	red sand	40	60
	Pea Gravel	60	80
	Gravel and sand	80	100
	Clay and sand	100	120
	sand	120	140
	sand	140	165
WELL LOCATION: sec. 27 T. 24 N. R. 3 E. 156 S W 8 1/2 miles S.E. Charleston (distance) (direction) of (nearest town)			
WELL PURPOSE: (home irrigation, municipal, industrial)			
WELL COMPLETION DATA:			
(1) diameter (inches) 4			
(2) total depth (feet) 152			
(3) static water level (feet) 20 below above top of ground.			
(4) casing PVC 142 (material) (depth)			
4 (size) if telescope see back.			
(5) screen 10 142 (length) (depth to top)			
4 PVC (size) (material)			
(6) pump 3/4 10 (HP) (yield gpm)			
elec. (type power)			
(7) electric log NO (yes or no)			
NI (organization running log)			
(8) how well bottom plugged PVC PIUG			
DRILLERS REMARKS:			

CODED

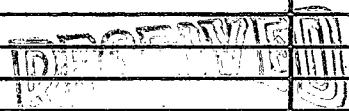

AUG 11 1975

MISS. BD. OF WATER COMMISSIONERS

