

MAD
 TALLAHATCHIE
 4-3-84

MISSISSIPPI
 BOARD OF WATER COMMISSIONERS
 416 North State Street
 Jackson, Mississippi 39201

CODED

WATER WELL DRILLERS LOG

4/3/84 date well completed
 Lipell Well Supply firm name
 Tallachia county well located

LANDOWNER: North Shady
 Grove Ch.

description of formations encountered	from	to
---------------------------------------	------	----

R+1 Coasville
 (mailing address)

Clay sand	0 20	20 60
--------------	---------	----------

WELL LOCATION:
 sec. 29 T 24 N S R 3 E W
 4 miles N of Coasville
 (distance) (direction) (nearest town)

WELL PURPOSE: Home
 (home, irrigation, municipal, industrial)

CODED

- WELL COMPLETION DATA:
- (1) diameter (inches) 4
 - (2) total depth (feet) 60
 - (3) static water level (feet) 20 ^{below} _{above} top of ground.
 - (4) casing PVC, 70
 (material) (depth)
 4 (size) if telescope see back.
 - (5) screen 10, 70
 (length) (depth to top)
 4, PVC
 (size) (material)
 - (6) pump 1/2, 10
 (HP) (yield gpm)
 elec
 (type power)
 - (7) electric log No
 (yes or no)
- (organization running log)
- (8) how well bottom plugged PVC
 Cap

DEPT. OF NATURAL RESOURCES
 BUREAU OF LAND & WATER RESOURCES


APR 23 1984

RECEIVED

DRILLERS REMARKS:

If well telescopes please sketch and show depths.

GROUND LEVEL

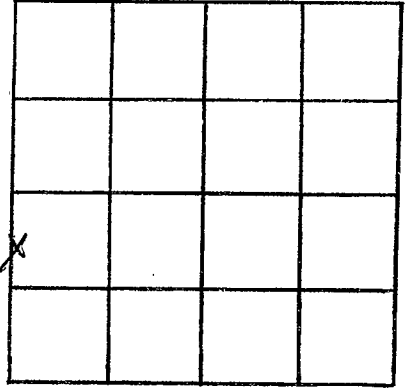

SECTION 29

Please indicate well location X.

ADDITIONAL INFORMATION

If more than one screen,
show locations of each on sketch.