

TALLAHATCHIE

M 2000

3-30-76

MISSISSIPPI  
 BOARD OF WATER COMMISSIONERS  
 416 North State Street  
 Jackson, Mississippi 39201

WATER WELL DRILLERS LOG

3-30 1976 Lipe Well Co. Tallahatchie  
 date well completed firm name county well located

LANDOWNER:

Deward Bloodworth

Charleston MS.  
(mailing address)

description of formations encountered

from to

|               |     |     |
|---------------|-----|-----|
| Top Soil      | 0   | 20  |
| Clay          | 20  | 40  |
| Sand and Clay | 40  | 60  |
| " " "         | 60  | 80  |
| " " "         | 80  | 100 |
| Sand          | 100 | 108 |

WELL LOCATION:

sec 19 T 24 (N) R 3 (E) S W

5 miles S. E. of Charleston  
(distance) (direction) (nearest town)


WELL PURPOSE:

(home, irrigation, municipal, industrial)

WELL COMPLETION DATA:


- (1) diameter (inches) 4
- (2) total depth (feet) 108
- (3) static water level (feet) 30 below top of ground.
- (4) casing PVC 98  
(material) (depth)
- 4 If telescope see back.  
(size)
- (5) screen 10 98  
(length) (depth to top)
- 4 PVC  
(size) (material)
- (6) pump 3/4 10  
(HP) (yield gpm)
- elec.  
(type power)
- (7) electric log no  
(yes or no)
- no  
(organization running log)
- (8) how well bottom plugged PVC  
CAP

DRILLERS REMARKS:

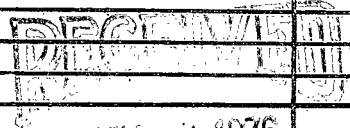

If well telescopes please sketch and show depths.

GROUND LEVEL

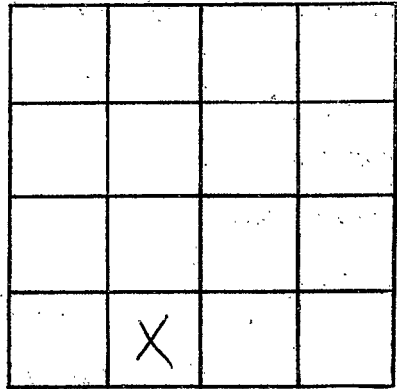

SECTION 19

Please indicate well location X.

ADDITIONAL INFORMATION

If more than one screen, show locations of each on sketch.