

Tallahatchie
 M 2001
 6-30-76

MISSISSIPPI
 BOARD OF WATER COMMISSIONERS
 416 North State Street
 Jackson, Mississippi 39201

WATER WELL DRILLERS LOG

6-30 1976 Lipe Well Co. Tallahatchie
 date well completed firm name county well located

LANDOWNER: W.C. Miller Scobey Ms. (mailing address)	description of formations encountered	from	to
		TOP soil	0
	red sand	20	40
	clay	40	60
	gravel	60	80
		80	100
	white sand	100	120
		120	166

WELL LOCATION:
 sec. 27 T. 24 N. R. 3 E. W. 8 miles S. E. of Charleston
 (distance) (direction) (nearest town)

WELL PURPOSE:
 (home) Irrigation, municipal, industrial

- WELL COMPLETION DATA:
- (1) diameter (inches) 4
 - (2) total depth (feet) 166
 - (3) static water level (feet) 120 below above top of ground.
 - (4) casing PVC 156
 (material) (depth)
 - 4 if telescope see back.
 (size)
 - (5) screen 10 156
 (length) (depth to top)
 - 4 PVC
 (size) (material)
 - (6) pump 3/4 10
 (HP) (yield gpm)
 - elec.
 (type power)
 - (7) electric log non
 (yes or no)
 - non
 (organization running log)
 - (8) how well bottom plugged PVC
cap


DRILLERS REMARKS:

RECEIVED
 JUL 7 1978

MISS. BD. OF WATER COMMISSIONERS

If well telescopes please sketch and show depths.

GROUND LEVEL

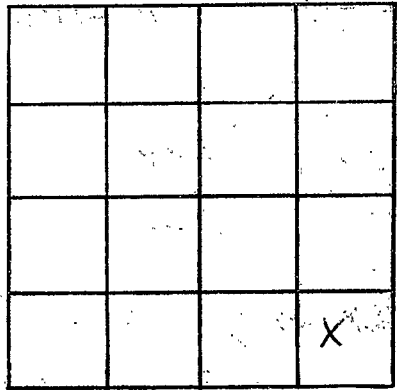

SECTION 27

Please indicate well location X.

ADDITIONAL INFORMATION

If more than one screen,
show locations of each on sketch.