

Tallahatchie
 M 2002
 11/20/76

MISSISSIPPI
 BOARD OF WATER COMMISSIONERS
 416 North State Street
 Jackson, Mississippi 39201

WATER WELL DRILLERS LOG

11-20 1976 Lipe Well Co. Tallahatchie
 date well completed firm name county well located

LANDOWNER:
 James Rutledge
 Scobey Ms.
 (mailing address)

WELL LOCATION:
 3 sec. 9 T. 24 S. R. 3 E.
 5 miles West of Scobey
 (distance) (direction) (nearest town)

WELL PURPOSE:
 (home, irrigation, municipal, industrial)

- WELL COMPLETION DATA:
- (1) diameter (inches) 4
 - (2) total depth (feet) 156
 - (3) static water level (feet) 100 below above top of ground.
 - (4) casing PVC 146
 (material) (depth)
4 if telescope see back.
 (size)
 - (5) screen 10 146
 (length) (depth to top)
4 PVC
 (size) (material)
 - (6) pump 3/4 10
 (HP) (yield gpm)
elec
 (type power)
 - (7) electric log non
 (yes or no)
non
 (organization running log)
 - (8) how well bottom plugged PVC
plug

description of formations encountered	from	to
	Top Soil	0
red sand	20	40
Gravel	40	60
"	60	80
sand	80	100
"	100	156


RECEIVED
 DEC 20 1976

DRILLERS REMARKS:

MISS. BD. OF WATER COMMISSIONERS

If well telescopes please sketch and show depths.

GROUND LEVEL

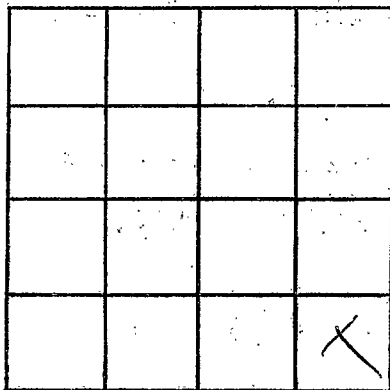

SECTION 9

Please indicate well location X.

ADDITIONAL INFORMATION

If more than one screen,
show locations of each on sketch.