

Tallahatchie  
 M 2004  
 7/18/77

MISSISSIPPI  
 BOARD OF WATER COMMISSIONERS  
 416 North State Street  
 150 Jackson, Mississippi 39201

WATER WELL DRILLERS LOG


July 18 1977 Lipe Well Co Tallahatchie  
 date well completed firm name county well located

LANDOWNER:	description of fomations encountered	from	to
Heeth Bloodworth Charleston Ms. (mailing address)			
	red sand	20	40
	gravel	40	60
	sand and gravel	60	80
	white clay	80	100
	sand	100	120
	ll	120	156
WELL LOCATION: sec. 27 T 24 N R 3 E 6 miles East of Charleston (distance) (direction) (nearest town)			
WELL PURPOSE: (home, irrigation, municipal, industrial)			
WELL COMPLETION DATA:			
(1) diameter (inches) 4			
(2) total depth (feet) 156			
(3) static water level (feet) 132 below top of ground.			
(4) casing PVC 146 (material) (depth)			
4 If telescope see back. (size)			
(5) screen 10 146 (length) (depth to top)			
4 PVC (size) (material)			
(6) pump 3/4 10 (HP) (yield gpm)			
elec. (type power)			
(7) electric log no (yes or no)			
no (organization running log)			
(8) how well bottom plugged PVC CAP			
DRILLERS REMARKS:			

RECEIVED  
 AUG - 1 - 1977

If well telescopes please sketch and show depths.

GROUND LEVEL

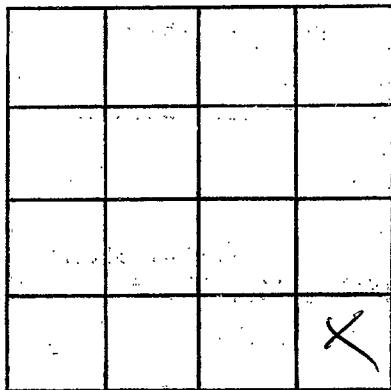

SECTION 27

Please indicate well location X.

ADDITIONAL INFORMATION

If more than one screen,  
show locations of each on sketch.