

MISSISSIPPI DEPARTMENT OF NATURAL RESOURCES

Bureau of Land and Water Resources

Southport Mall

P.O. Box 10631

Jackson, Mississippi 39209

WATER WELL DRILLERS LOG

WATER MATCHES
M 2005

10-14 19 85 LIPE WELL & SUPPLY GRADY
date well completed firm name county well located

LANDOWNER: DON CROUCH

Rt. 2 Box 287

HOLCOMB, MS
(mailing address)

WELL LOCATION:

sec 30 T 24 N R 3 E
S W
5 miles N of CASSELLA
(distance) (direction) (nearest town)

WELL PURPOSE: HOME
(home, irrigation, municipal, industrial)

WELL COMPLETION DATA:

- (1) diameter (inches) 4"
- (2) total depth (feet) 245
- (3) static water level (feet) 160 below above top of ground.
- (4) casing PVC, 235,
(material) (depth)

_____ If telescope see back.
(size)

- (5) screen 10', 235'
(length) (depth to top)

4", PVC
(size) (material)

- (6) pump 3/4, 10
(HP) (yield gpm)

230 10
(type power)

- (7) electric log NO
(yes or no)

(organization running log)

- (8) how well bottom plugged CAP

description of formations encountered

from

to

clay	0	20
" "	20	30
peg. c.	30	40
s. clay	40	60
sand & gravel	60	80
gravel	80	100
gravel	100	120
gravel	120	135
l. clay	135	140
sand & clay	140	155
clay	155	160
clay & sand	160	177
sand	177	180
sand	180	200
sand	200	220
sand	220	240
sand	240	245


REGISTERED
WATER WELL DRILLER
STATE OF MISSISSIPPI
NO. 191986
MAY 19 1986

DRILLERS REMARKS:

Department of Natural Resources
Bureau of Land and Water Resources
MISSISSIPPI

If well telescopes please sketch and show depths.

GROUND LEVEL

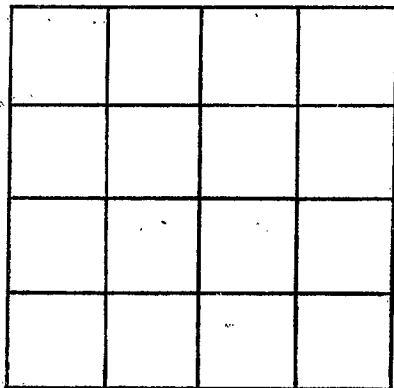

SECTION _____

Please indicate well location X.

ADDITIONAL INFORMATION

If more than one screen,
show locations of each on sketch.