

TALLAHASSEE MISSISSIPPI BOARD OF WATER COMMISSIONERS

N-9

2-7-57

WATER WELL DRILLERS LOG

0353

**CODED**

**CODED**

Date: Feb 7 1957, Driller: Layne-Central Company County Tallahatchie  
(Name)

(1) Owner of Land: Equen Plantation  
(Name)  
Minter City, Mississippi  
(Address) 2726  
34, 85

(2) Location: 1/4, 1/4, Sec. 25 T23R2W  
6 miles northwest of Minter City  
(distance) (direction) (Nearest Town)

(3) Topography: flat  
(Hilly) (Flat) (Level)

(4) Purpose of Well: irrigation  
(Domestic Irrigation  
Municipal, Industrial, Other)

Description & Color of Materials Sand, Clay, Red Clay, Shell, etc.	Thick- ness Feet	Depth Feet
Clay	14	14
Fine sand	41	55
Coarse sand	30	85
Fine sand	5	90
Coarse sand & pea gravel	10	100
Rock	4	104
Coarse sand & pea gravel	8	112
Bottom in clay.		

Information upon completion of well:

(1) Diameter 12x10 inches.

(2) Total Depth 112 feet.

(3) Water Level 20 feet below top of ground.

(4) Cased to 61'-5", Size 12",  
1'-7" swage

(5) Screen: Size 10", Length 50'


(6) Were any formations sealed against pollution?  
no yes, no no.

If YES depth of formation \_\_\_\_\_

Why \_\_\_\_\_

Drillers Remarks:  
1227 GPM  
engine drive

**CODED**

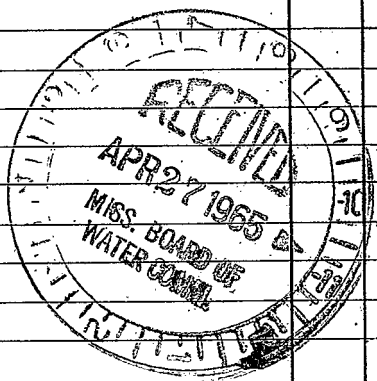

(Use Back Side)

Well No.

100

100

100

100