

Tallahatchie
 N 10.
 8-69

MISSISSIPPI
 BOARD OF WATER COMMISSIONERS
 416 North State Street
 Jackson, Mississippi 39201

CODED

WATER WELL DRILLERS LOG

8/2 date well completed 1969
 Delta Wells Supply Co. firm name
 Tallahatchie county well located

LANDOWNER:

J. C. Bulford
 Glendora, Miss.
 (mailing address)

description of formations encountered

from to

Top Clay	0	22
Thin Sand	22	32
Thin Sand Clay	32	55
Clay	55	80
Sand & Gravel	60	105
Sand Rock		

WELL LOCATION:

sec. 14 T 23 N R 2 E
 4 miles West of Glendora
 (distance) (direction) (nearest town)

WELL PURPOSE: Drinking
 (home, irrigation, municipal, industrial)

WELL COMPLETION DATA:

- (1) diameter (inches) 16
- (2) total depth (feet) 105
- (3) static water level (feet) 19 below above top of ground.
- (4) casing steel (material) (depth)
- (size) if telescope see back.
- (5) screen 40 65 (length) (depth to top)
16 steel (size) (material)
- (6) pump 1500 (HP) (yield gpm)
IP Gas (type power)
- (7) electric log _____ (yes or no)
 (organization running log)
- (8) how well bottom plugged Concrete


NOV 4 1969

MISS. BD. OF
 WATER

DRILLERS REMARKS:

If well telescopes please sketch and show depths.

GROUND LEVEL

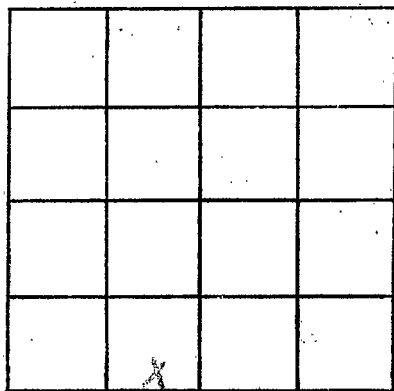

SECTION 14

Please indicate well location X.

ADDITIONAL INFORMATION

If more than one screen, show locations of each on sketch.